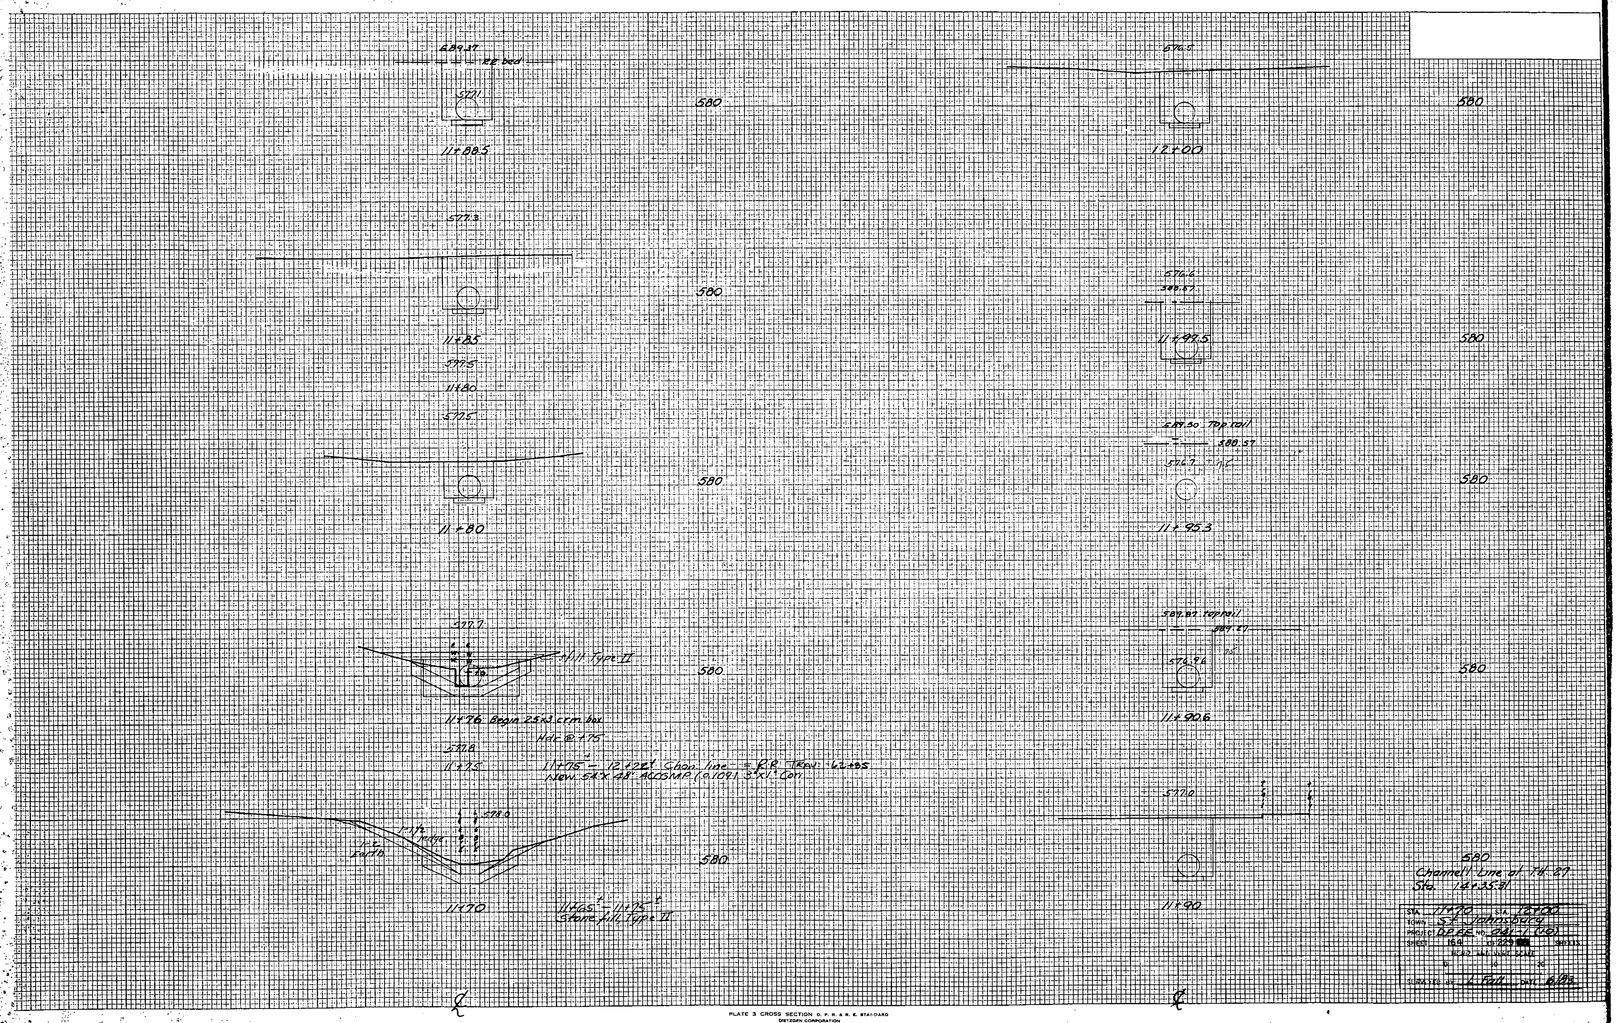

PLATE 3 CROSS SECTION © P.A.N.A.N.A. STANDARD
SNYDER CORPORATION