

Double 4' Restrictive white line

Int. 20 - on ramp 100%

Ramp B (short) 50% gore

Int. 19 - set ramp gore






































Notes

1. Gore markings shown are approximate. See STD 517.150 for gore area, acceleration, deceleration lane pavement markings.
2. Shaded portions indicate paving limits.
3. Signage required per STD 517.152 on US 2, Ramp CD and Montpelier State Hwy under Demonstration Project No. 60 using epoxy thermoplastic traffic marking material.

5. The word marking "STOP" shall be placed with a 4' gap between the word marking and the stop bar.

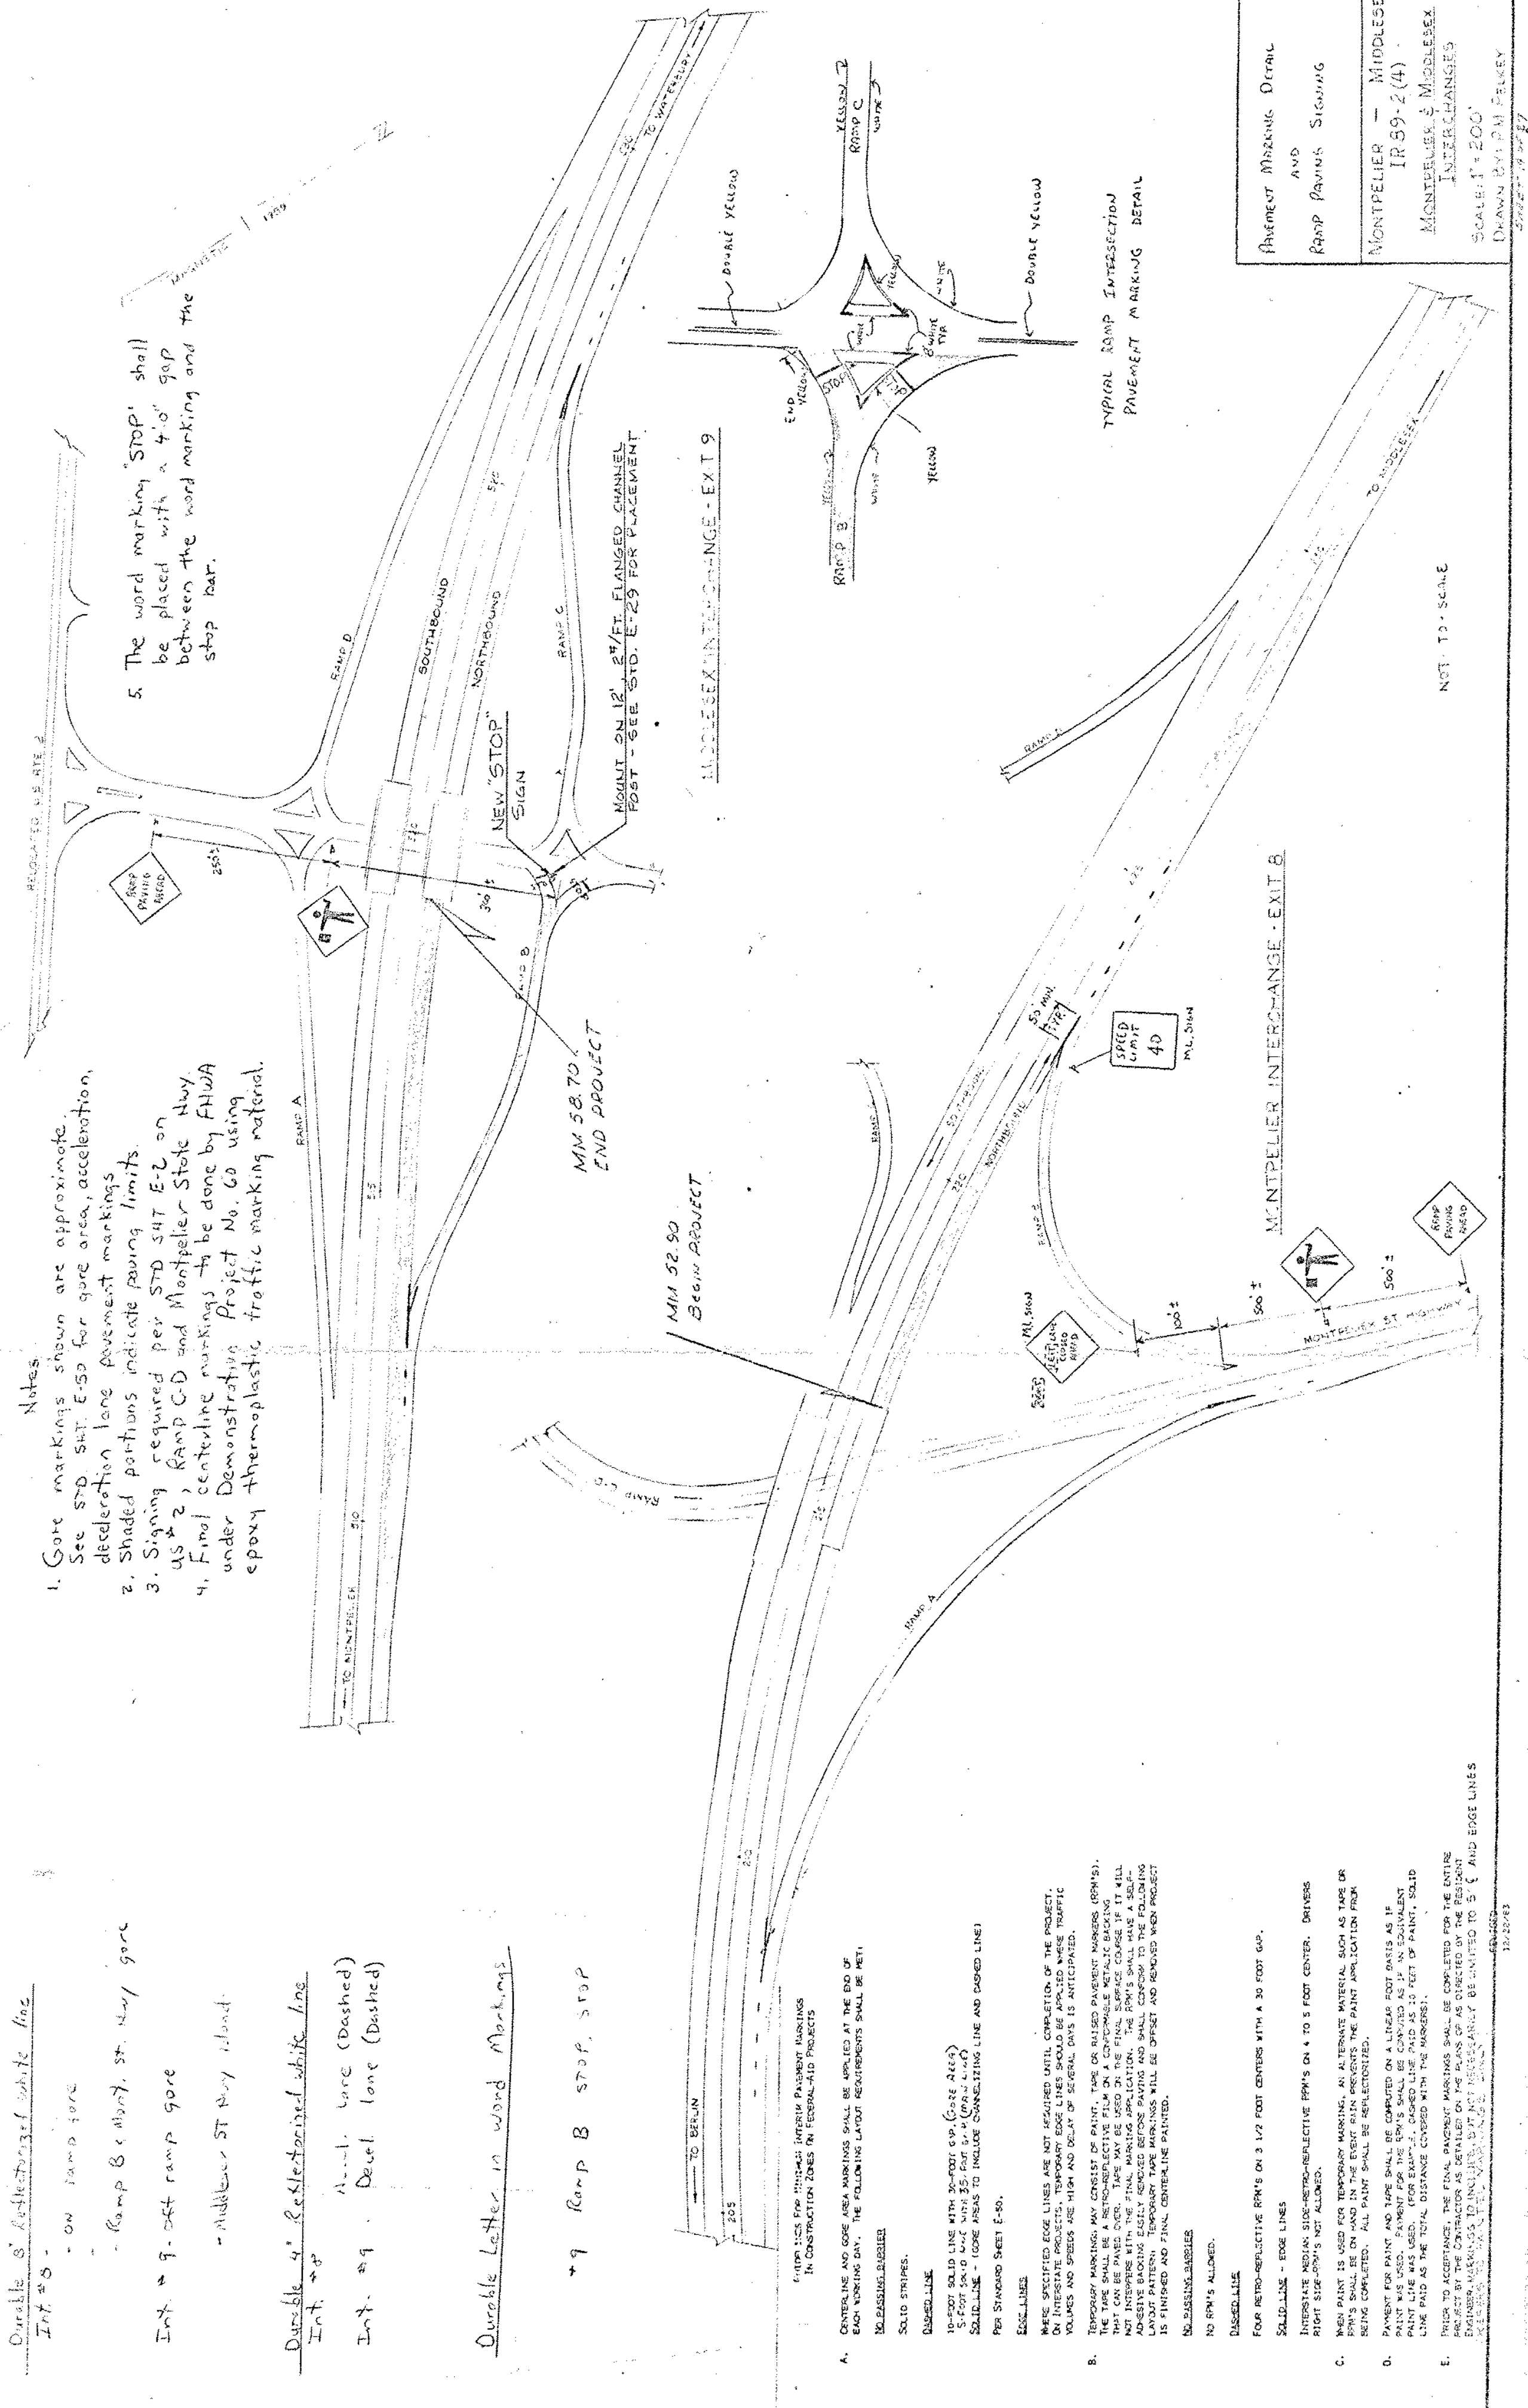

1. CENTERLINE AND GORE AREA MARKINGS SHALL BE APPLIED AT THE END OF EACH TRAVEL WAY. THE FOLLOWING LAYOUT REQUIREMENTS SHALL BE MET:

- A. CENTERLINE - SOLID LINE
- B. GORE AREA MARKINGS - SOLID LINE - GORE AREAS TO INCLUDE CENTERLINE AND DASHED LINE
- C. SOLID LINE
- D. DASHED LINE
- E. FROM RETRO-REFLECTIVE PAVEMENT OR 3 1/2 FOOT CENTERS WITH A 30 FOOT SPA.
- F. SOLID LINE - EDGE LINES
- G. INTERSTATE MARKING SIGN-RETRO-REFLECTIVE PAVEMENT ON 4 TO 8 FOOT CENTERS. DELIVERS RIGHT TURN SHOULDER NOT ALLOWED.

MONTPELIER - MIDDLESEX
MONTPELIER & MIDDLESEX
INTERCHANGES

NOT TO SCALE

MONTPELLIER INTERCHANGE - EXT 8

MIN 58.70
END PROJECT

BEGIN PROJECT

TO MONTPELIER

TO MIDDLESEX








