STATE OF VERMONT
AGENCY OF TRANSPORTATION

TRAFFIC SIGN SUMMARY SHEET 16

MILE MARKER, STATION OR SIGN NUMBER	SIGN LEGEND	SIGN DIMENSIONS EA	WIDTH (in)	HEIGHT (in)	NEW & SALVAGED SIGNS "A"	"B"	SALV SIGN	SALV TIS	EXIST POST RETAIN	SALVAGE	NEW SIGN POSTS NO. OF POSTS	FLANGED CHANNEL lb/ft 1.12	2.0	3.0	SQUARE STEEL (in) lb/ft 1.75	2.0	2.5	ANCHOR	SLEEVE	TUBULAR ALUMINUM DIA (in) lb/ft 3.0	4.0	4.0Mod	FND-ATION	TUBULAR STEEL DIA (in) lb/ft 3.0	3.5	4.0	5.0	W-SHAPE STEEL FTG. SIZE 24"	30"	WEIGHT	POST SIZE	SIGN FRAME	REMARKS	SIGN DETAIL DETAIL ON SHEET NUMBER	STD. SHEET NUMBER
																				1.3	1.7	1.7		7.6	9.0	10.8	14.6								
172.660 NB MED		1	36	12	3.00						2					X		2															R6-1R		E-142
172.849 NB		1	48	36	12.00						2												2	X									R8-7		E-142
172.930 NB		1	30	15	3.13																												M3-1		E-135
		1	36	36	9.00																												M1-1		E-135
		1	36	36	9.00						1												1	X									M1-10		E-135
172.959 NB MED		1	36	36	9.00						2					X		2															R3-4		E-143
173.000 NB 173.800 NB	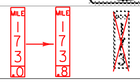	5 ~~1~~	12	60 ~~48~~	25.00 ~~4.00~~						5 ~~1~~					X		5 ~~1~~															D10-3		E-139
173.040 NB		1	48	48	16.00																												VW-397	152	
		1	24	18	3.00						2												2	X									VP-396	152	
173.140 NB		1	48	60	20.00																												R2-1		E-142
		1	48	48	16.00						2												2		X								VR-141		E-142
173.490 NB	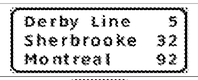	1	120	48		40.00					2												2		X									150	
173.740 NB		1	48	60	20.00						2												2	X									VR-132	152	
174.000 NB 174.800 NB	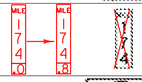	5 ~~1~~	12	60 ~~48~~	25.00 ~~4.00~~						5 ~~1~~					X		5 ~~1~~															D10-3		E-139
174.440 NB MED		1	36	36	9.00						2					X		2															R3-4		E-143
174.530 NB		1	6	10	0.42						1				X			1															VD-701	154	
175.000 NB 175.800 NB		5 ~~1~~	12	60 ~~48~~	25.00 ~~4.00~~						5 ~~1~~					X		5 ~~1~~															D10-3		E-139
												FT	FT	FT	FT 8.2	FT 128.2	FT		EA.	LB	LB	LB		LB 729.6	LB 610.2	LB	LB							
SUBTOTALS SHEET 16					SF ~~141.55~~ 204.55	SF 40.00	EA.	SF				FT			FT 136.4					LB			EA. 11	LB 1339.8				EA.	EA.	LB				

FINAL POST LENGTHS ARE TO BE DETERMINED IN THE FIELD. POST SIZES ARE COMPUTED BASED ON INFORMATION FURNISHED ON THE STANDARD SHEETS AND THE VTRANS "SIGN POST DESIGN GUIDELINE".

PROJECT NAME: LYNDON-DERBY
PROJECT NUMBER: IM IR 091-3(6)

FILE NAME:	080159_tss_mainline.xls	PLOT DATE:	5/7/2009
PROJECT LEADER:	CRB	DRAWN BY:	BDB
DESIGNED BY:	PTS	CHECKED BY:	DAM
TRAFFIC SIGN SUMMARY SHEET # 16		SHEET 75	OF 160