STATE OF VERMONT
AGENCY OF TRANSPORTATION

TRAFFIC SIGN SUMMARY SHEET 21

MILE MARKER, STATION OR SIGN NUMBER	SIGN LEGEND	SIGN DIMENSIONS EA	WIDTH (in)	HEIGHT (in)	NEW & SALVAGED SIGNS "A"	"B"	SALV SIGN	SALV TIS	EXIST POST RETAIN	EXIST POST SALVAGE	NEW SIGN POSTS NO. OF POSTS	FLANGED CHANNEL lb/ft 1.12	2.0	3.0	SQUARE STEEL (in) lb/ft 1.75 1.88	2.0 2.42	2.5 3.35	ANCHOR	SLEEVE	TUBULAR ALUMINUM DIA (in) lb/ft 3.0 1.3	4.0 1.7	4.0Mod 1.7	TUBULAR STEEL DIA (in) FNDATION	lb/ft 3.0 7.6	3.5 9.0	4.0 10.8	5.0 14.6	W-SHAPE STEEL FTG. SIZE 24"	30"	WEIGHT	POST SIZE	SIGN	FRAME	REMARKS	SIGN DETAIL DETAIL ON SHEET NUMBER	STD. SHEET NUMBER
147.950 SB MED		1	48	48	16.00																													VW-001	152	
		1	30	24	5.00						2												2	X									VW-249	152	
148.000 SB 148.800 SB	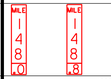	5 ~~1~~	12	60 ~~48~~	25.00 ~~4.00~~						5 ~~1~~					X		5 ~~1~~															D10-3		E-139
148.300 SB MED		1	36	36	9.00						2					X		2															R3-4		E-143
148.420 SB		1	6	10	0.42						1				X			1															VD-701	154	
148.560 SB		1	6	10	0.42						1				X			1															VD-701	154	
149.000 SB 149.800 SB	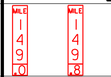	5 ~~1~~	12	60 ~~48~~	25.00 ~~4.00~~						5 ~~1~~					X		5 ~~1~~															D10-3		E-139
150.000 SB 150.800 SB	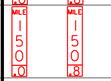	5 ~~1~~	12	60 ~~48~~	25.00 ~~4.00~~						5 ~~1~~					X		5 ~~1~~															D10-3		E-139
150.730 SB MED		1	36	36	9.00						2					X		2															R3-4		E-143
150.810 SB MED		1	36	36	9.00						2					X		2															R3-4		E-143
151.000 SB 151.800 SB	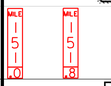	5 ~~1~~	12	60 ~~48~~	25.00 ~~4.00~~						5 ~~1~~					X		5 ~~1~~															D10-3		E-139
151.540 SB		1	6	10	0.42						1				X			1															VD-701	154	
152.000 SB 152.800 SB		5 ~~1~~	12	60 ~~48~~	25.00 ~~4.00~~						5 ~~1~~					X		5 ~~1~~															D10-3		E-139
152.030 SB		1	6	10	0.42						1				X			1															VD-701	154	
152.460 SB MED		1	36	36	9.00						2					X		2															R3-4		E-143
152.780 SB		1	36	30	7.50						2					X		2															I-2		E-131
153.000 SB 153.800 SB		5 ~~1~~	12	60 ~~48~~	25.00 ~~4.00~~						5 ~~1~~					X		5 ~~1~~															D10-3		E-139
												FT	FT	FT	FT 33.2	FT 230.2	FT		EA.	LB	LB	LB		LB 220.4	LB	LB	LB								
		SUBTOTALS SHEET 21			SF ~~216.18~~ ~~90.18~~	SF	EA.	SF				FT			FT 263.4					LB			EA. 2	LB 220.4				EA.	EA.	LB						

FINAL POST LENGTHS ARE TO BE DETERMINED IN THE FIELD. POST SIZES ARE COMPUTED BASED ON INFORMATION FURNISHED ON THE STANDARD SHEETS AND THE VTRANS "SIGN POST DESIGN GUIDELINE".

PROJECT NAME: LYNDON-DERBY
PROJECT NUMBER: IM IR 091-3(6)

FILE NAME: 080159_tss_mainline.xls
PROJECT LEADER: CRB
DESIGNED BY: PTS
TRAFFIC SIGN SUMMARY SHEET # 21

PLOT DATE: 5/7/2009
DRAWN BY: BDB
CHECKED BY: DAM