STATE OF VERMONT
AGENCY OF TRANSPORTATION

TRAFFIC SIGN SUMMARY SHEET 33

MILE MARKER, STATION OR SIGN NUMBER	SIGN LEGEND	SIGN DIMENSIONS EA	WIDTH (in)	HEIGHT (in)	NEW & SALVAGED SIGNS "A"	"B"	SALV SIGN	SALV TIS	EXIST POST RETAIN	EXIST POST SALVAGE	NEW SIGN POSTS NO. OF POSTS	FLANGED CHANNEL lb/ft 1.12	FLANGED CHANNEL lb/ft 2.0	FLANGED CHANNEL lb/ft 3.0	SQUARE STEEL (in) 1.75 lb/ft 1.88	SQUARE STEEL (in) 2.0 lb/ft 2.42	SQUARE STEEL (in) 2.5 lb/ft 3.35	ANCHOR	SLEEVE	TUBULAR ALUMINUM DIA (in) 3.0 lb/ft 1.3	TUBULAR ALUMINUM DIA (in) 4.0 lb/ft 1.7	TUBULAR ALUMINUM DIA (in) 4.0Mod lb/ft 1.7	TUBULAR STEEL DIA (in) FND-ATION	TUBULAR STEEL DIA (in) 3.0 lb/ft 7.6	TUBULAR STEEL DIA (in) 3.5 lb/ft 9.0	TUBULAR STEEL DIA (in) 4.0 lb/ft 10.8	TUBULAR STEEL DIA (in) 5.0 lb/ft 14.6	W-SHAPE STEEL FTG. SIZE 24"	FTG. SIZE 30"	WEIGHT	POST SIZE	SIGN FRAME	REMARKS	SIGN DETAIL DETAIL ON SHEET NUMBER	SIGN DETAIL STD. SHEET NUMBER
175.710 SB		1	48	60	20.00																												R2-1		E-142
		1	48	48	16.00						2												2		X							VR-141		E-142
175.805 SB		1	48	48	16.00																												VW-397	152	
		1	24	18	3.00						2										X												VP-396	152	
175.840 SB		1	6	10	0.42						1				X			1															VD-701	154	
175.900 SB		1	30	15	3.13																												M3-3		E-135
		1	36	36	9.00																												M1-1		E-135
		1	36	36	9.00						1												1	X								M1-10		E-135
175.980 SB	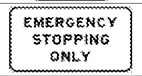	1	48	36	12.00						2												2	X								R8-7		E-142
176.000 SB		~~5~~ 1	12	~~60~~ 48	~~25.00~~ 4.00						~~5~~ 1					X		1															D10-3		E-139
176.080 SB MED		1	36	36	9.00						2					X		2															R3-4		E-143
176.106 SB		1	6	10	0.42						1				X			1															VD-701	154	
176.208 SB MED		1	36	12	3.00						2					X		2															R6-1R		E-142
176.363 SB		1	48	48	16.00						2												2	X								W4-1R		E-150
176.560 SB		1	78	78		42.25					2												2	X									153	
176.570 SB		1	18	18	2.25						1				X			1															OM1-1		E-150
176.700 SB		1	102	78		55.25					2												2			X							151	
												FT	FT	FT	FT 25.9	FT 72.9	FT		EA.	LB	LB 69.9	LB		LB 706.8	LB 324.9	LB 339.2	LB							
SUBTOTALS SHEET 33					SF ~~123.22~~ 144.22	SF 97.50	EA.	SF				FT			FT 98.8						LB 69.9		EA. ~~9~~ 11		LB 1370.9		EA.	EA.	LB						

FINAL POST LENGTHS ARE TO BE DETERMINED IN THE FIELD. POST SIZES ARE COMPUTED BASED ON INFORMATION FURNISHED ON THE STANDARD SHEETS AND THE VTRANS "SIGN POST DESIGN GUIDELINE".

PROJECT NAME: LYNDON-DERBY
PROJECT NUMBER: IM IR 091-3(6)

FILE NAME: 080159_tss_mainline.xls
PROJECT LEADER: CRB
DESIGNED BY: PTS
TRAFFIC SIGN SUMMARY SHEET # 33

PLOT DATE: 5/7/2009
DRAWN BY: BDB
CHECKED BY: DAM
SHEET 92 OF 160