STATE OF VERMONT
AGENCY OF TRANSPORTATION

TRAFFIC SIGN SUMMARY SHEET 34

MILE MARKER, STATION OR SIGN NUMBER	SIGN LEGEND	SIGN DIMENSIONS EA	SIGN DIMENSIONS WIDTH (in)	SIGN DIMENSIONS HEIGHT (in)	NEW & SALVAGED SIGNS "A"	NEW & SALVAGED SIGNS "B"	NEW & SALVAGED SIGNS SALV SIGN	NEW & SALVAGED SIGNS SALV TIS	EXIST POST RETAIN	EXIST POST SALVAGE	NEW SIGN POSTS NO. OF POSTS	FLANGED CHANNEL lb/ft 1.12	FLANGED CHANNEL lb/ft 2.0	FLANGED CHANNEL lb/ft 3.0	SQUARE STEEL (in) lb/ft 1.75 1.88	SQUARE STEEL (in) lb/ft 2.0 2.42	SQUARE STEEL (in) lb/ft 2.5 3.35	ANCHOR	SLEEVE	TUBULAR ALUMINUM DIA (in) lb/ft 3.0 1.3	TUBULAR ALUMINUM DIA (in) lb/ft 4.0 1.7	TUBULAR ALUMINUM DIA (in) lb/ft 4.0Mod 1.7	TUBULAR STEEL DIA (in) lb/ft FND-ATION	TUBULAR STEEL DIA (in) lb/ft 3.0 7.6	TUBULAR STEEL DIA (in) lb/ft 3.5 9.0	TUBULAR STEEL DIA (in) lb/ft 4.0 10.8	TUBULAR STEEL DIA (in) lb/ft 5.0 14.6	W-SHAPE STEEL FTG. SIZE 24"	W-SHAPE STEEL FTG. SIZE 30"	W-SHAPE STEEL WEIGHT	W-SHAPE STEEL POST SIZE	SIGN FRAME	REMARKS	SIGN DETAIL DETAIL ON SHEET NUMBER	SIGN DETAIL STD. SHEET NUMBER
176.800 SB		1	60	48	20.00						2										X														151	
176.900 SB		1	168	102		119.00																													151	
	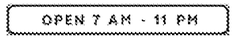	1	168	24		28.00					2																	2		843	W8X18		Bolt Tension 19.2 kips	151	
177.000 SB		1	12	60 ~~48~~	5.00 ~~4.00~~						1					X		1																D10-3		E-139