STATE OF VERMONT
AGENCY OF TRANSPORTATION

TRAFFIC SIGN SUMMARY SHEET 56

MILE MARKER, STATION OR SIGN NUMBER	SIGN LEGEND	SIGN DIMENSIONS EA	WIDTH (in)	HEIGHT (in)	NEW & SALVAGED SIGNS "A"	"B"	SALV SIGN	SALV TIS	EXIST POST RETAIN	EXIST POST SALVAGE	NEW SIGN POSTS NO. OF POSTS	FLANGED CHANNEL lb/ft 1.12	2.0	3.0	SQUARE STEEL (in) lb/ft 1.75 1.88	2.0 2.42	2.5 3.35	ANCHOR	SLEEVE	TUBULAR ALUMINUM DIA (in) lb/ft 3.0 1.3	4.0 1.7	4.0Mod 1.7	TUBULAR STEEL DIA (in) lb/ft FND-ATION	3.0 7.6	3.5 9.0	4.0 10.8	5.0 14.6	W-SHAPE STEEL FTG. SIZE 24"	30"	WEIGHT	POST SIZE	SIGN	FRAME	REMARKS	SIGN DETAIL DETAIL ON SHEET NUMBER	STD. SHEET NUMBER
0.102 RAMP A RT	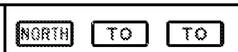	1	24	12	2.00																												M3-1		E-136B
		1	24	12	2.00																												M4-5		E-136A
		1	24	12	2.00																												M4-5		E-136B
		1	30	24	5.00																												M1-5		E-136B
		1	24	24	4.00																												M1-4		E-136A
		1	30	24	5.00																												M1-5		E-136B
		1	21	15	2.19																												M6-2		E-136B
		1	21	15	2.19																												M6-2		E-136A
		1	21	15	2.19						2												2	X							#3		M6-2		E-136B
0.140 RAMP A RT		1	72	12	6.00																												D1-1a		E-123
		1	72	12	6.00						2					X		2															D1-1a		E-123
0.178 RAMP A RT		1	72	10	5.00																												VD-502S		E-133
		1	72	10	5.00																												VD-502H		E-133
		1	36	24	6.00																												R5-1a BACK TO BACK		E-143
		1	72	10	5.00																												VD-502C		E-133
		1	72	10	5.00						2					X		2					2	X									VD-502BP		E-133
0.178 RAMP A LT		1	36	24	6.00																												R5-1a		E-143
		1	24	24	4.00						2					X		2															R9-4a		E-143
0.223 RAMP A RT		1	18	18	2.25						1				X			1															OM1-1		E-150
0.226 RAMP A LT	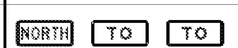	1	24	12	2.00																												M3-1		E-136B
		1	24	12	2.00																												M4-5		E-136A
		1	24	12	2.00																												M4-5		E-136B
		1	30	24	5.00																												M1-5		E-136B
		1	24	24	4.00																												M1-4		E-136A
		1	30	24	5.00																												M1-5		E-136B
		1	21	15	2.19																												M6-2		E-136B
		1	21	15	2.19																												M6-2		E-136A
		1	21	15	2.19						2												2	X							#3		M6-2		E-136B
0.230 RAMP A RT		1			3.90						1					X		1															R1-2 36"x36"x36"		E-146
INT #27 0.047 RAMP B RT		1			3.90						1					X		1															R1-2 36"x36"x36"		E-146
0.050-0.170 RT RAMP B		7	18	24	21.00						7					X		7															W1-8 TYPE IX SHEETING (BLACK ON YELLOW)		E-150
												FT	FT	FT	FT 9.5	FT 178.0	FT		EA.	LB	LB	LB		LB 531.4	LB	LB	LB								
		SUBTOTALS SHEET 56	SF 132.19	SF	EA.	SF		FT							FT 187.5					LB			EA. 6		LB 531.4				EA.	EA.	LB				

FINAL POST LENGTHS ARE TO BE DETERMINED IN THE FIELD. POST SIZES ARE COMPUTED BASED ON INFORMATION FURNISHED ON THE STANDARD SHEETS AND THE VTRANS "SIGN POST DESIGN GUIDELINE".

PROJECT NAME: LYNDON-DERBY
PROJECT NUMBER: IM IR 091-3(6)

FILE NAME: 080159_tss_interchanges.x
PROJECT LEADER: CRB
DESIGNED BY: PTS
TRAFFIC SIGN SUMMARY SHEET # 56

PLOT DATE: 5/7/2009
DRAWN BY: BDB
CHECKED BY: DAM