STATE OF VERMONT
AGENCY OF TRANSPORTATION

TRAFFIC SIGN SUMMARY SHEET 60

MILE MARKER, STATION OR SIGN NUMBER	SIGN LEGEND	SIGN DIMENSIONS EA	WIDTH (in)	HEIGHT (in)	NEW & SALVAGED SIGNS "A"	"B"	SALV SIGN	SALV TIS	EXIST POST RETAIN	EXIST POST SALVAGE	NEW SIGN POSTS NO. OF POSTS	FLANGED CHANNEL lb/ft 1.12	2.0	3.0	SQUARE STEEL (in) 1.75 lb/ft 1.88	2.0 lb/ft 2.42	2.5 lb/ft 3.35	ANCHOR	SLEEVE	TUBULAR ALUMINUM DIA (in) 3.0 lb/ft 1.3	4.0 lb/ft 1.7	4.0Mod lb/ft 1.7	TUBULAR STEEL DIA (in) FND-ATION	3.0 lb/ft 7.6	3.5 lb/ft 9.0	4.0 lb/ft 10.8	5.0 lb/ft 14.6	W-SHAPE STEEL FTG. SIZE 24"	30"	WEIGHT	POST SIZE	SIGN FRAME	REMARKS	SIGN DETAIL DETAIL ON SHEET NUMBER	STD. SHEET NUMBER
0.064 VT 191 RT	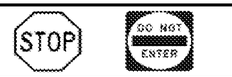	1	30	30	6.25																												R1-1		E-143
		1	30	30	6.25																												BACK TO BACK		
																																	R5-1		E-143
		1	36	12	3.00																												R6-1L		E-142
																																	BACK TO BACK		
		1	36	12	3.00						1					X		1														R6-1R		E-142
0.074 VT 191 RT		1	24	30	5.00																												R4-7		E-144
		1	18	18	2.25						1					X		1	1														OM1-1		E-150
0.085 VT 191 RT		1	24	12	2.00																												M3-3		E-135
		1	24	24	4.00																												M1-1		E-135
		1	21	15	2.19						1					X		1															M5-1		E-135
0.100 VT 191 LT	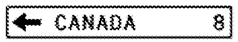	1	72	12	6.00						2					X		2															D1-1a		E-123
0.115 VT 191 RT		1	30	30	6.25						1					X		1															VR-921		E-145A
0.217 VT 191 RT		1	24	12	2.00																												M3-3		E-135
		1	24	24	4.00																												M1-1		E-135
		1	21	15	2.19			2			1					X		1															M6-1		E-135
																POST REPLACED 4/27/11																			
0.217 VT 191 LT		1	24	30	5.00																												R4-7		E-144
		1	18	18	2.25						1					X		1	1														OM1-1		E-150
0.228 VT 191 RT		1	30	30	6.25																												R1-1		E-143
		1	30	30	6.25																												BACK TO BACK		
																																	R5-1		E-143
		1	36	12	3.00																												R6-1L		E-142
																																	BACK TO BACK		
		1	36	12	3.00						1					X		1															R6-1R		E-142
												FT	FT	FT	FT	FT 123.8	FT		EA. 2	LB	LB	LB		LB	LB	LB	LB								
SUBTOTALS SHEET 60		SF 80.13	SF	EA.	SF 2							FT				FT 123.8				LB			EA.	LB				EA.	EA.	LB					

FINAL POST LENGTHS ARE TO BE DETERMINED IN THE FIELD. POST SIZES ARE COMPUTED BASED ON INFORMATION FURNISHED ON THE STANDARD SHEETS AND THE VTRANS "SIGN POST DESIGN GUIDELINE".

PROJECT NAME: LYNDON-DERBY
PROJECT NUMBER: IM IR 091-3(6)

FILE NAME: 080159_tss_interchanges.x
PROJECT LEADER: CRB
DESIGNED BY: PTS
TRAFFIC SIGN SUMMARY SHEET # 60

PLOT DATE: 5/7/2009
DRAWN BY: BDB
CHECKED BY: DAM