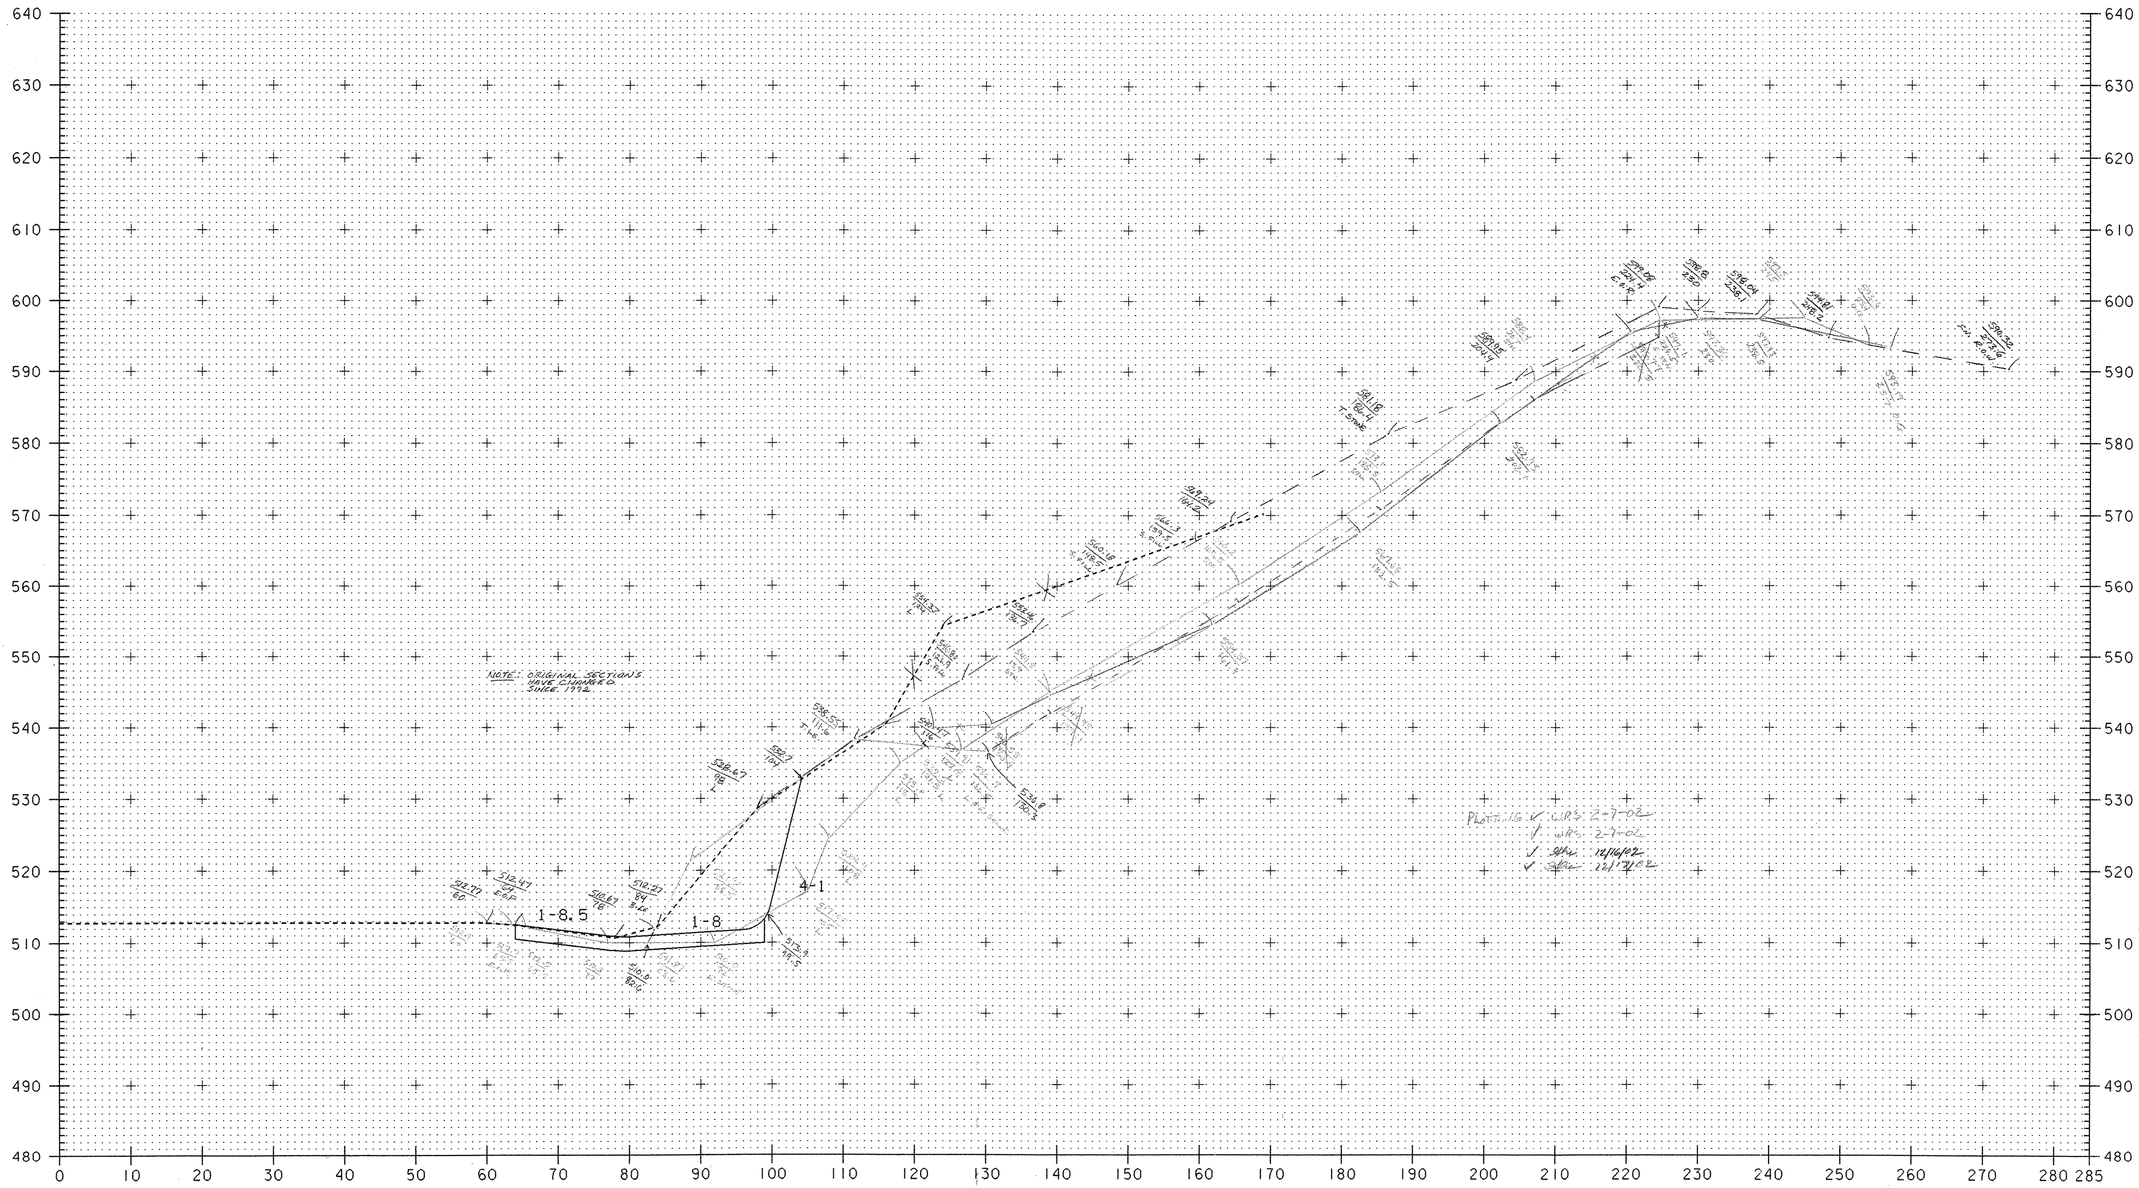

648+50 (NB OUTSIDE)

LEDGE REMOVAL

0 10 20

SCALE IN FEET

DATUM	
VERTICAL	assumed 500
HORIZONTAL	n/a

PROJECT: HARTFORD-ROYALTON	PROJECT NO.: IM IR 089-1(8)
DESIGN FILE NAME: /sqda/87a008/mml2.dgn IPARM FILE NAME: ml2xs03.i SURVEYED BY: gilman SQUAD LEADER: a. kreis	PLOT DATE: 12-MAR-1999 SURVEY DATE: fall 92 DRAWN BY: jf gruchacz SHEET: 163 OF 260