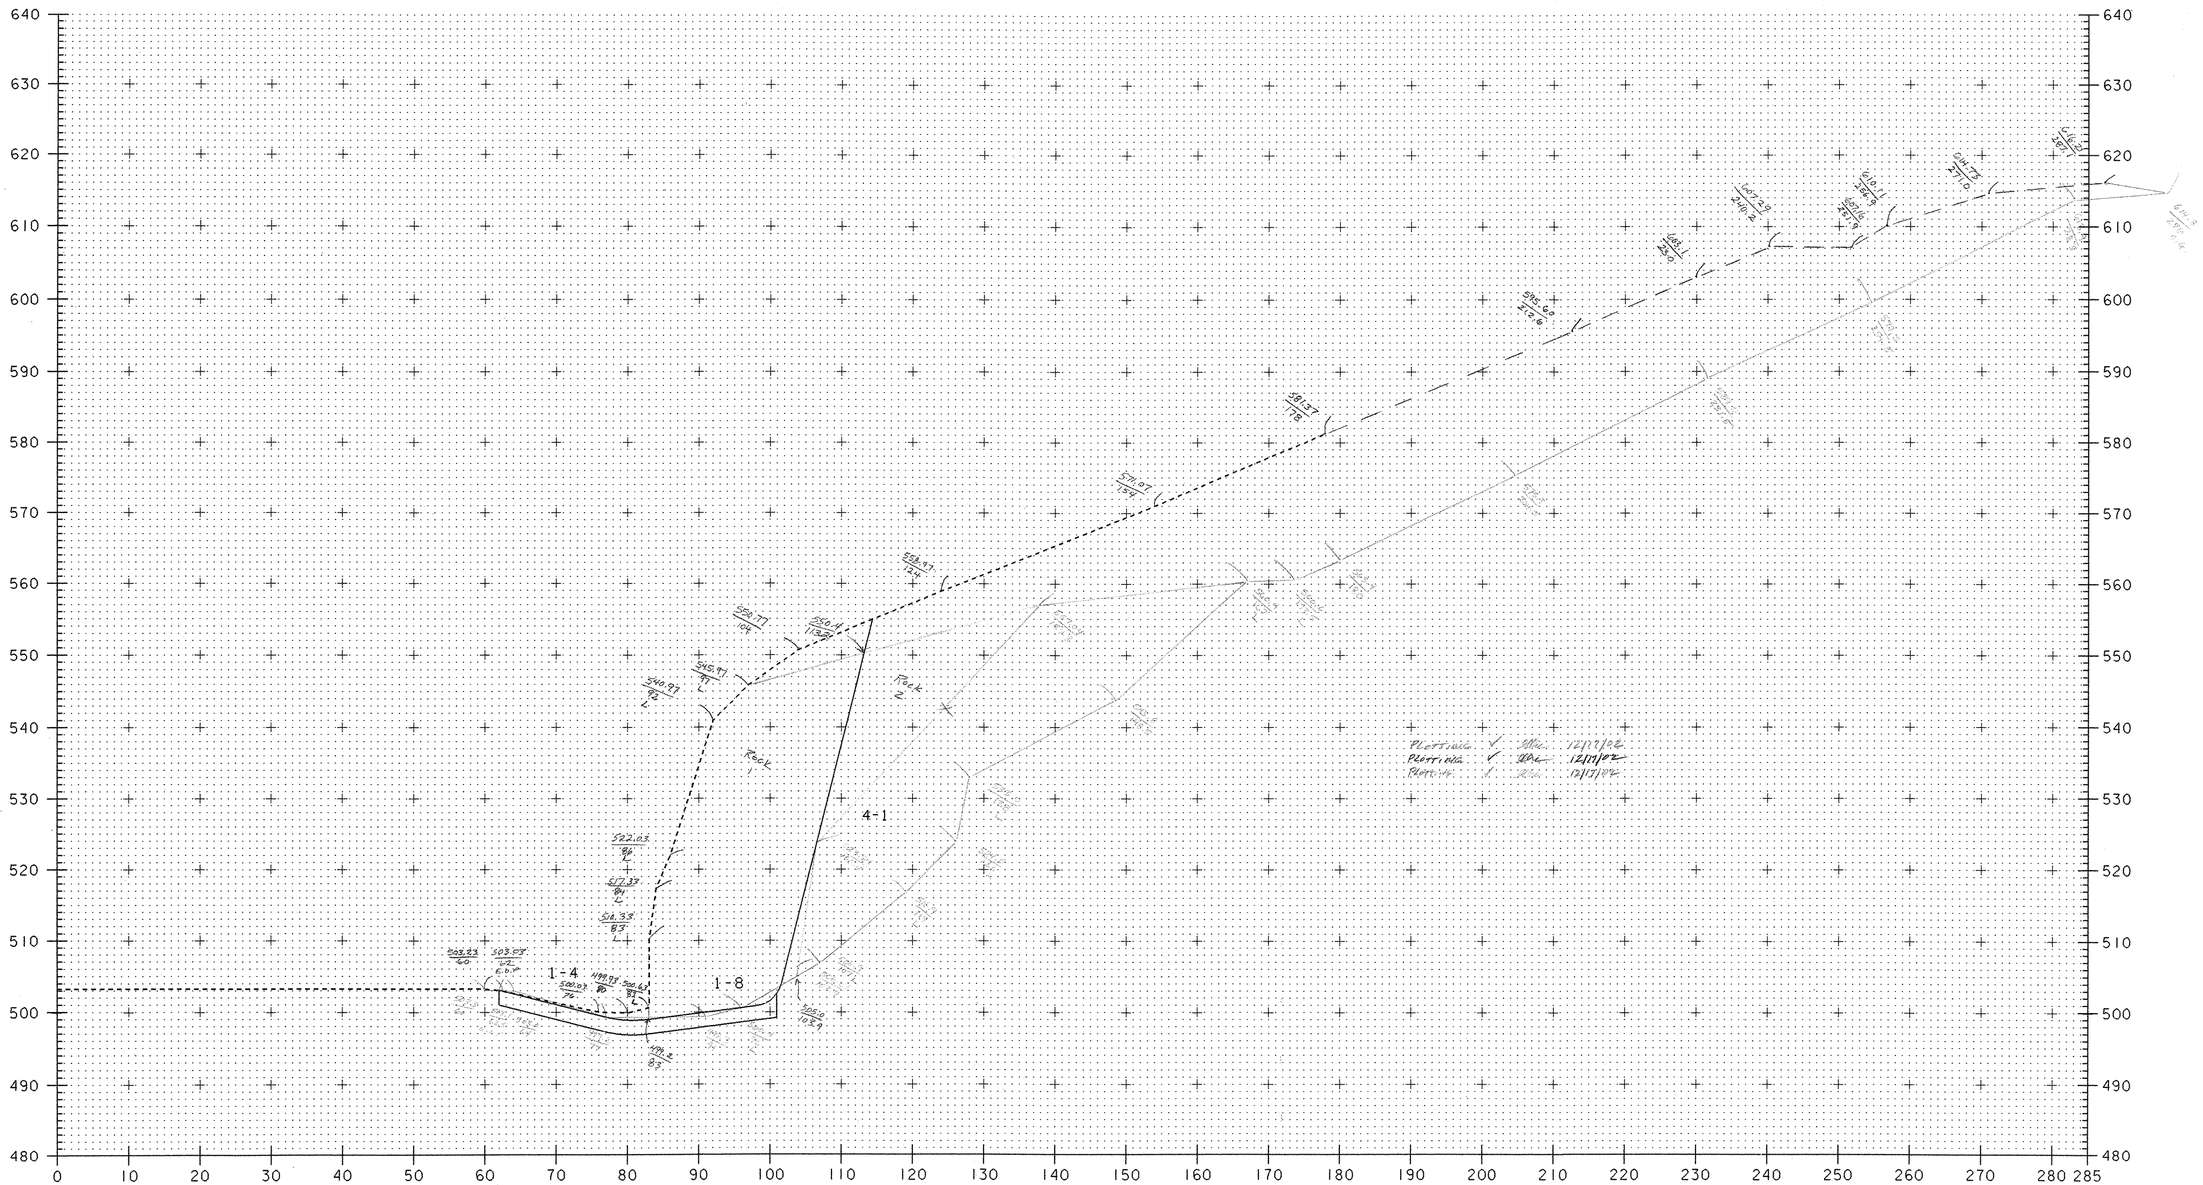

651+75 (NB OUTSIDE)

LEDGE REMOVAL

0 10 20
SCALE IN FEET

DATUM
VERTICAL assumed 500
HORIZONTAL n/a

PROJECT: HARTFORD-ROYALTON	PROJECT NO.: IM IR 089-1(8)
DESIGN FILE NAME: /sqda/87a008/mml2.dgn IPARM FILE NAME: ml2xsl6.i SURVEYED BY: gilman SQUAD LEADER: a. kreis	PLOT DATE: 12-MAR-1999 SURVEY DATE: fall 92 DRAWN BY: jf gruchacz SHEET: 176 OF 260