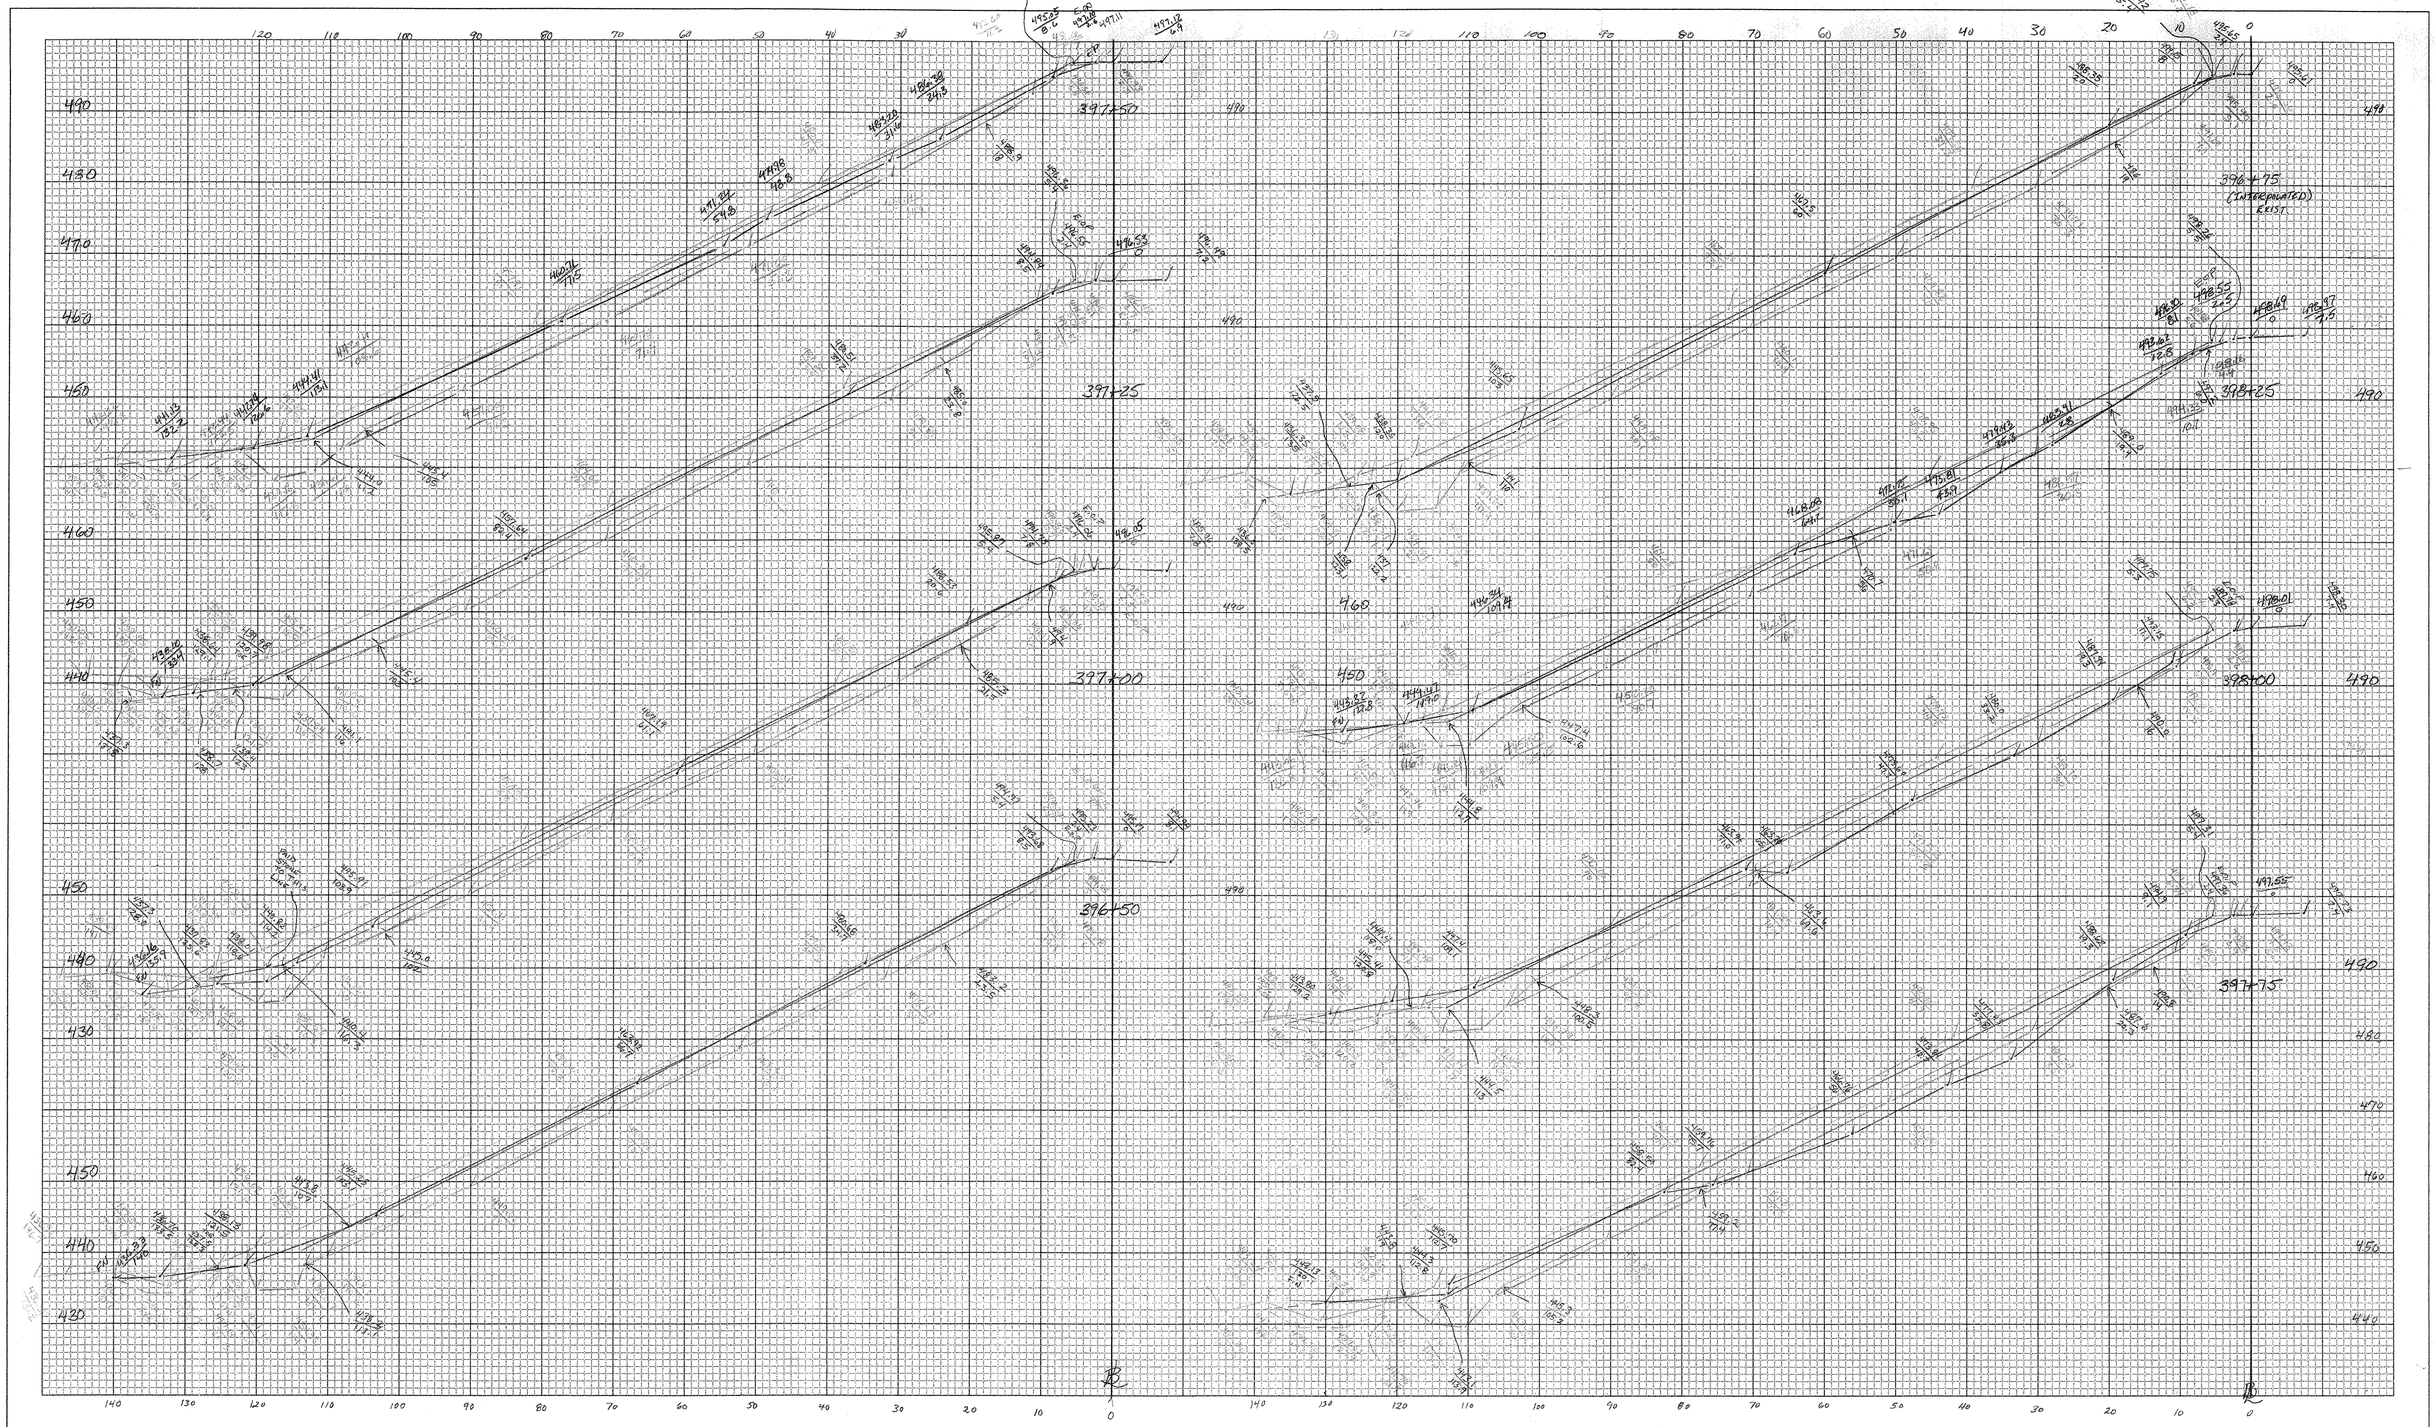

CROSS SECTION SHEET

PROJECT NAME: HARTFORD - ROYALTON

PROJECT NUMBER: IM IR 089-1(8)

FILE NAME: SLIDE AREA #7.28 SB LT

PROJECT LEADER:

DESIGNED BY:

const: g:/common/cadd/e-xsection.dgn

PLOT DATE: 05-JUN-2000 09

DRAWN BY:

CHECKED BY:

SHEET 1800 OF