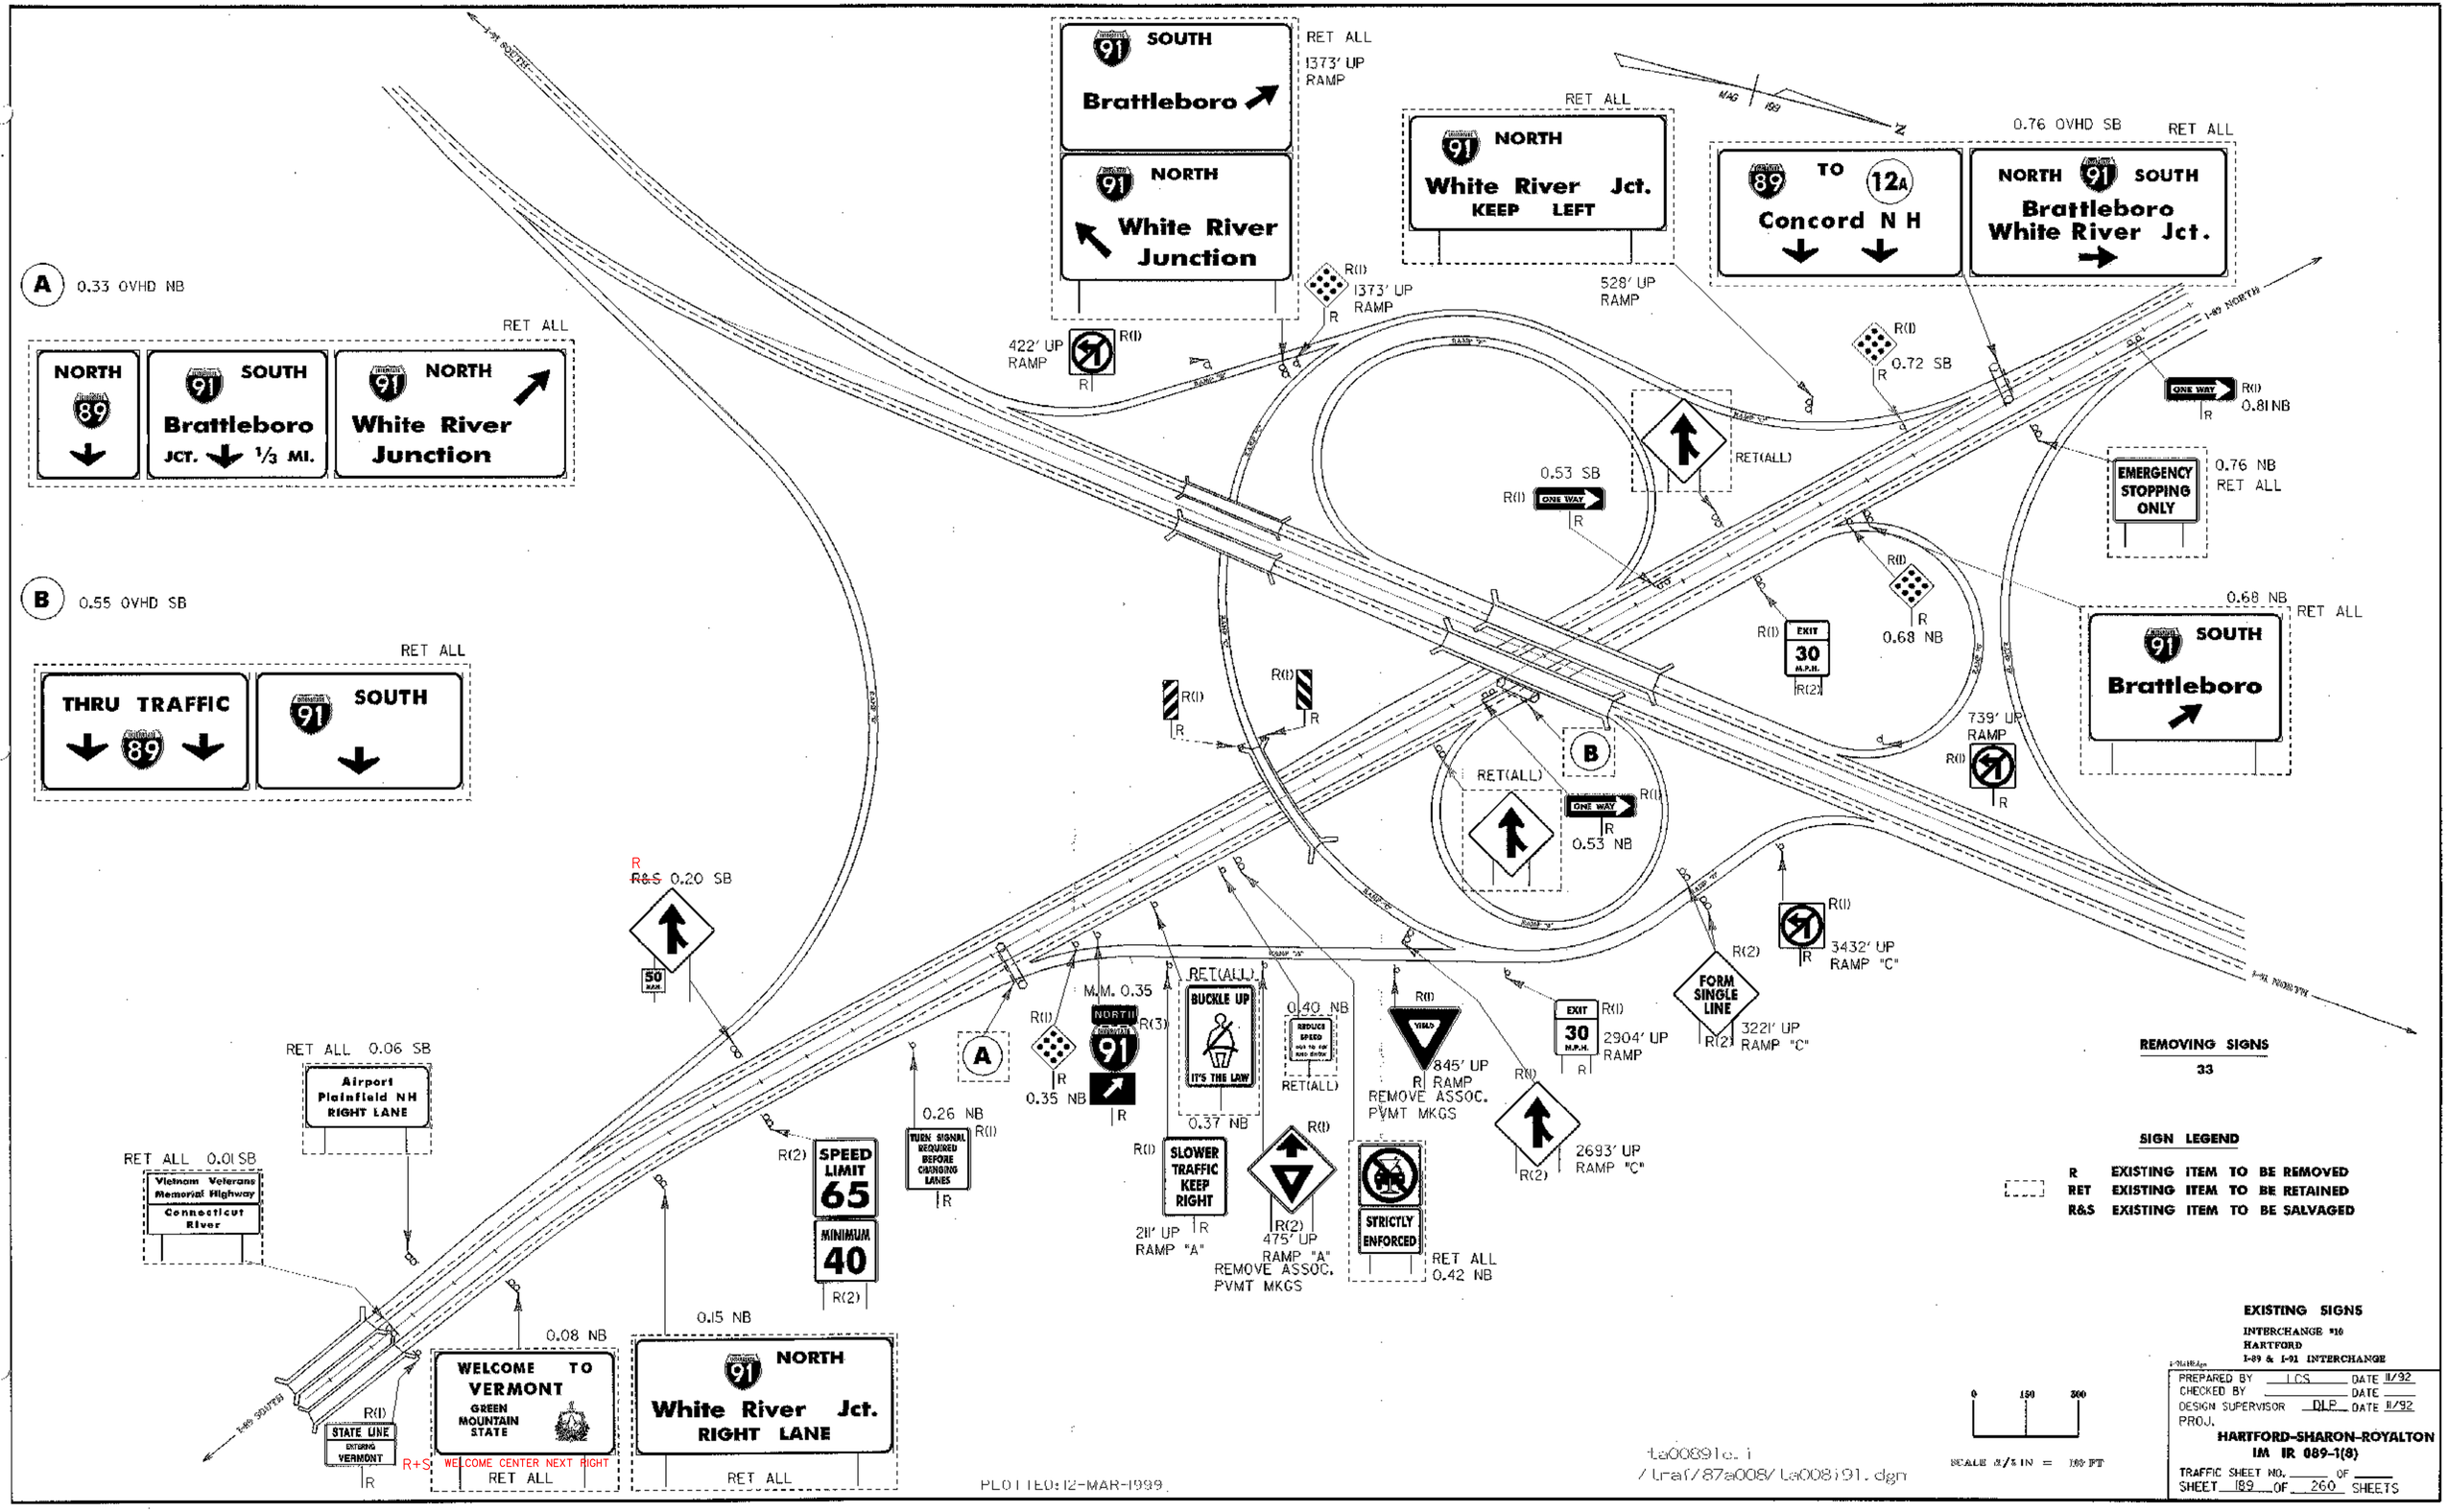
A 0.33 OVHD NB
RET ALL
NORTH 89
SOUTH 91 Brattleboro JCT. 1/3 MI.
NORTH 91 White River Junction
B 0.55 OVHD SB
RET ALL
THRU TRAFFIC 89
SOUTH 91
SOUTH 91 Brattleboro
RET ALL
1373' UP RAMP
NORTH 91 White River Junction
422' UP RAMP
R(I)
1373' UP RAMP
RET ALL
NORTH 91 White River Jct. KEEP LEFT
528' UP RAMP
0.76 OVHD SB
RET ALL
TO 89 12A Concord N H
NORTH 91 SOUTH Brattleboro White River Jct.
0.72 SB
0.81 NB
ONE WAY
0.76 NB RET ALL
EMERGENCY STOPPING ONLY
0.53 SB
RET(ALL)
0.68 NB
RET ALL
SOUTH 91 Brattleboro
EXIT 30 M.P.H.
R(2)
739' UP RAMP
0.53 NB
RET(ALL)
R&S 0.20 SB
50 M.P.H.
3432' UP RAMP "C"
FORM SINGLE LINE
3221' UP RAMP "C"
2904' UP RAMP
2693' UP RAMP "C"
M.M. 0.35
NORTH 91
0.35 NB
BUCKLE UP IT'S THE LAW
0.37 NB
0.40 NB
REDUCE SPEED
RET(ALL)
YIELD
845' UP RAMP
REMOVE ASSOC. PVMT MKGS
0.26 NB
TURN SIGNAL REQUIRED BEFORE CHANGING LANES
SLOWER TRAFFIC KEEP RIGHT
211' UP RAMP "A"
475' UP RAMP "A"
REMOVE ASSOC. PVMT MKGS
STRICTLY ENFORCED
RET ALL 0.42 NB
RET ALL 0.06 SB
Airport Plainfield NH RIGHT LANE
RET ALL 0.01 SB
Vietnam Veterans Memorial Highway
Connecticut River
SPEED LIMIT 65
MINIMUM 40
0.08 NB
0.15 NB
WELCOME TO VERMONT GREEN MOUNTAIN STATE
WELCOME CENTER NEXT RIGHT
RET ALL
NORTH 91 White River Jct. RIGHT LANE
RET ALL
STATE LINE ENTERING VERMONT
I-89 SOUTH
I-91 NORTH
MAG 199
REMOVING SIGNS
33
SIGN LEGEND
R EXISTING ITEM TO BE REMOVED
RET EXISTING ITEM TO BE RETAINED
R&S EXISTING ITEM TO BE SALVAGED
0 150 300
SCALE 1/8 IN = 100 FT
ta00891c.i
/traf/87a008/ta00891.dgn
PLOTTED: 12-MAR-1999
EXISTING SIGNS
INTERCHANGE #10
HARTFORD
I-89 & I-91 INTERCHANGE
PREPARED BY LCS DATE 11/92
CHECKED BY DATE
DESIGN SUPERVISOR DLP DATE 11/92
PROJ.
HARTFORD-SHARON-ROYALTON
IM IR 089-1(8)
TRAFFIC SHEET NO. OF
SHEET 189 OF 260 SHEETS