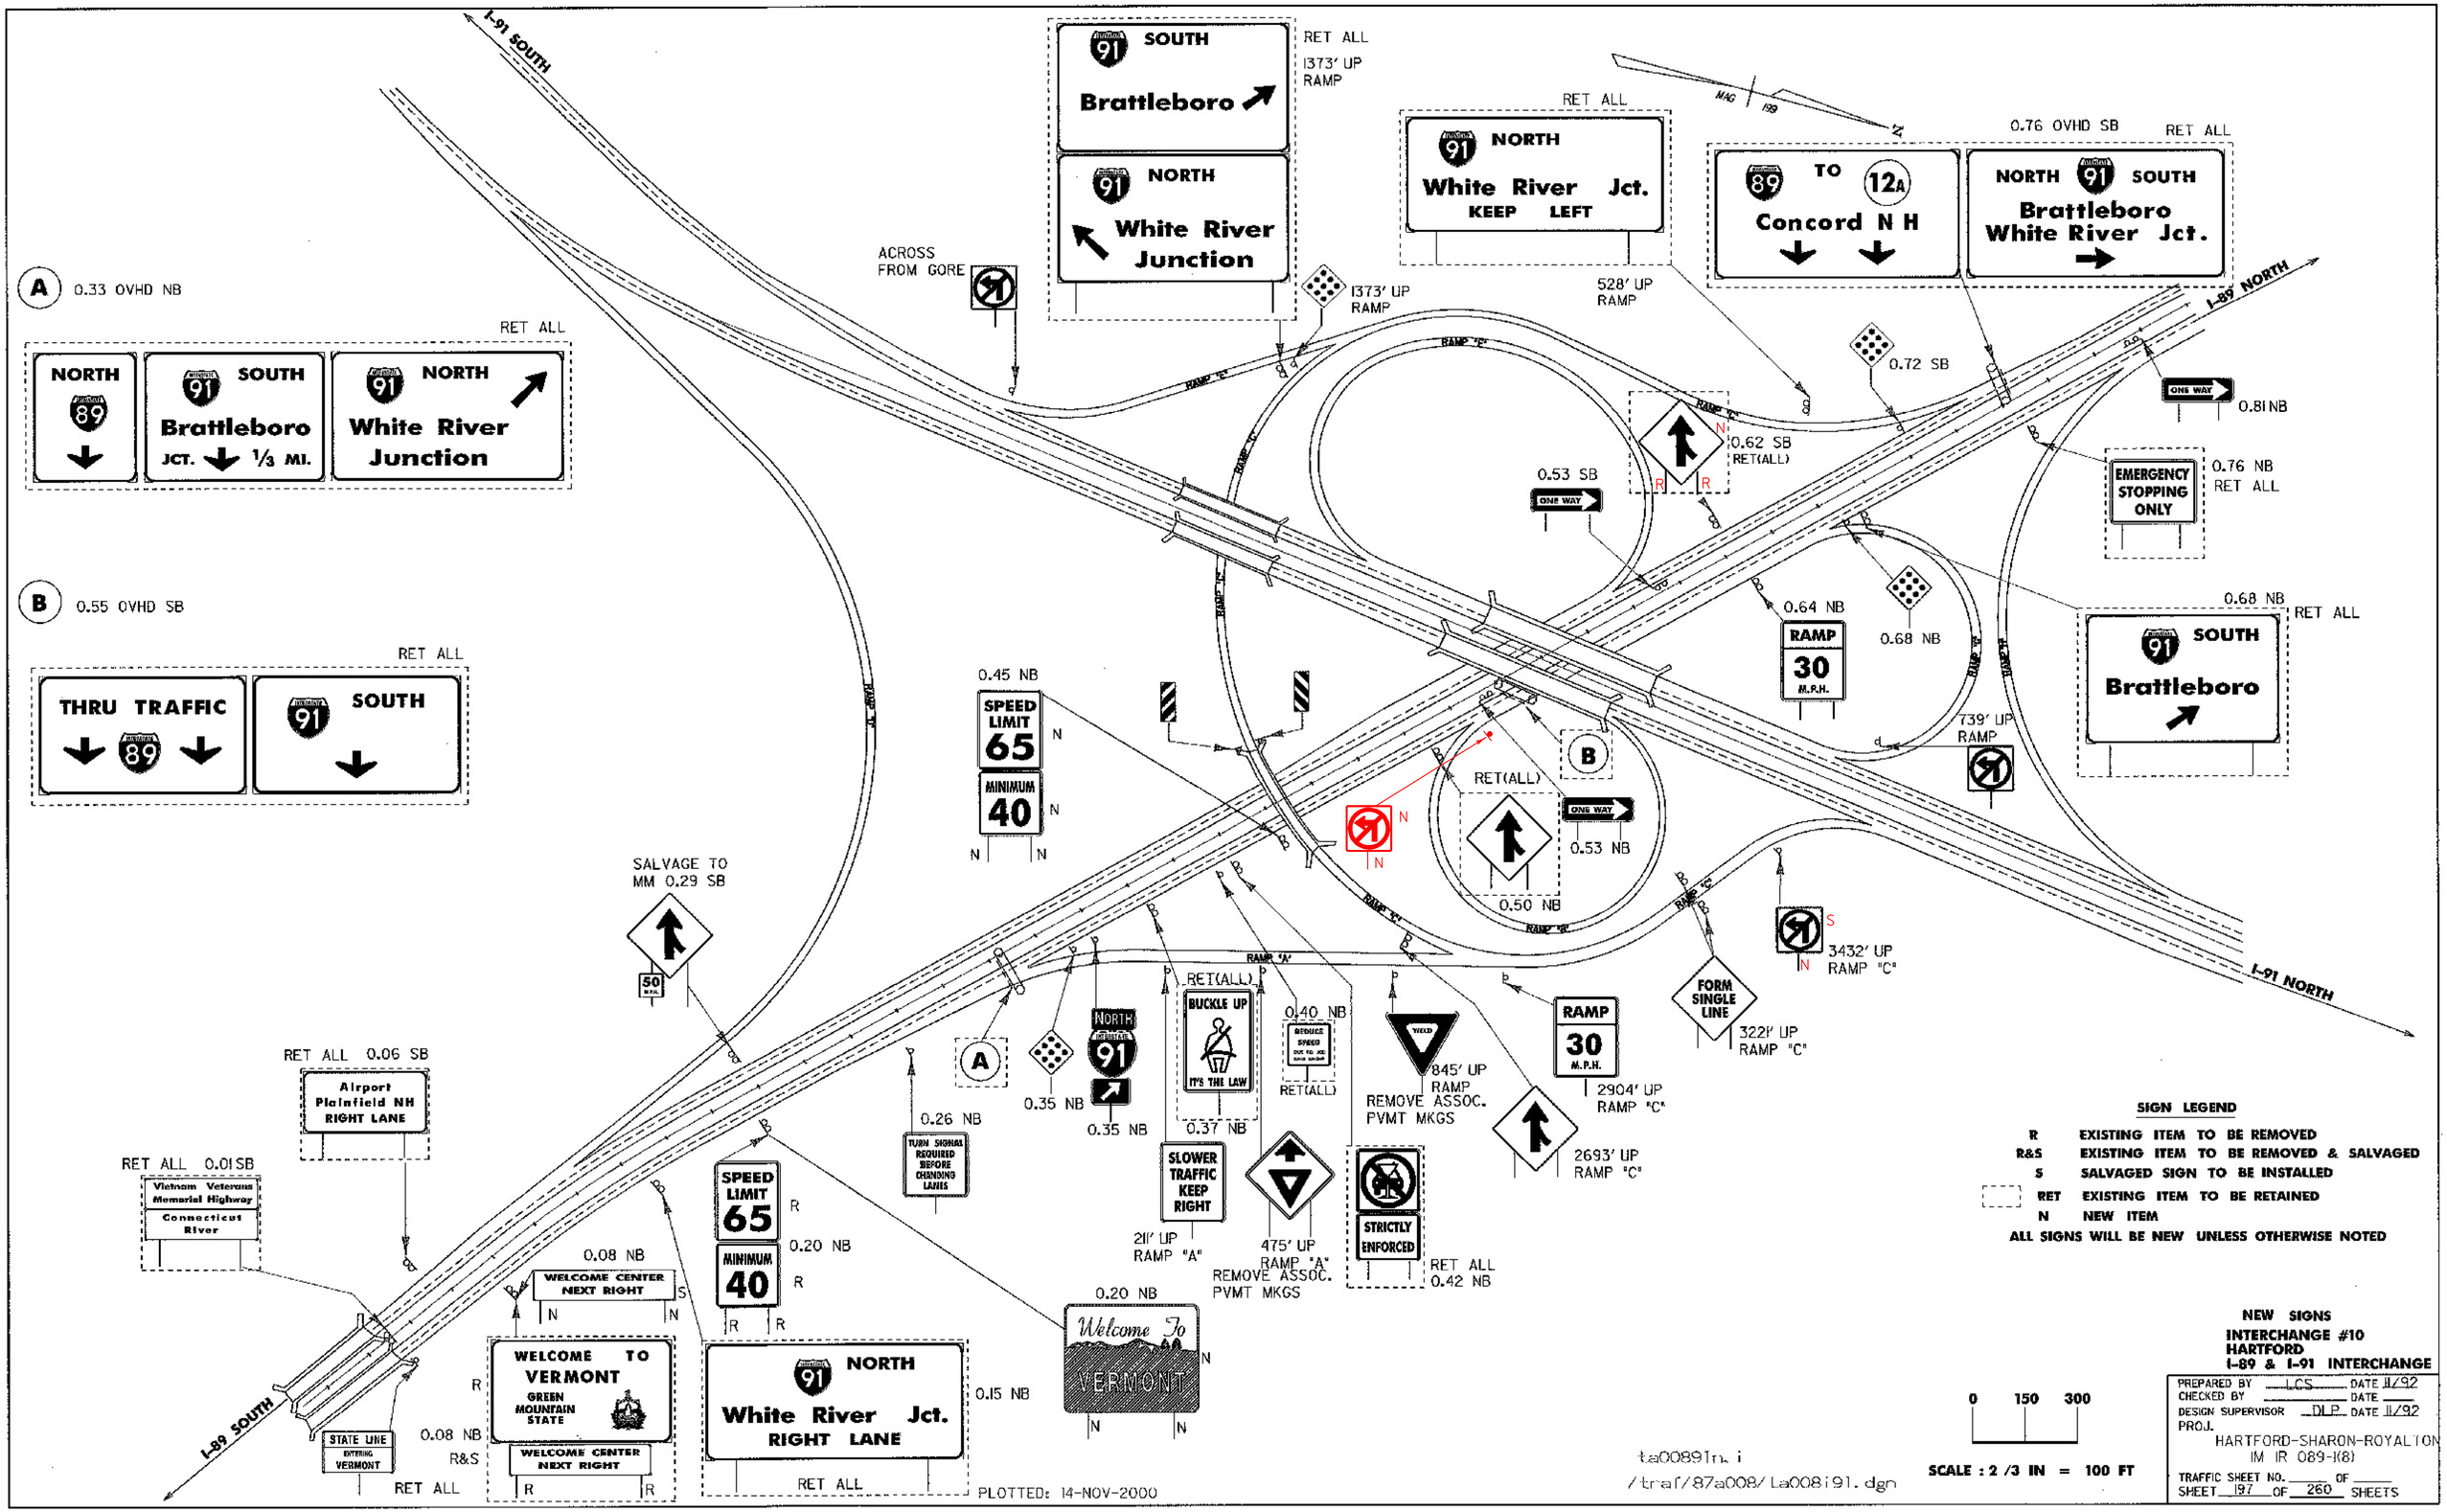
I-91 SOUTH
I-91 NORTH
I-89 NORTH
I-89 SOUTH
A 0.33 OVHD NB
RET ALL
NORTH 89
SOUTH 91 Brattleboro JCT. 1/3 MI.
NORTH 91 White River Junction
B 0.55 OVHD SB
RET ALL
THRU TRAFFIC 89
SOUTH 91
SOUTH 91 Brattleboro
RET ALL
1373' UP RAMP
NORTH 91 White River Junction
ACROSS FROM GORE
1373' UP RAMP
NORTH 91 White River Jct.
KEEP LEFT
528' UP RAMP
0.76 OVHD SB
RET ALL
89 TO 12A Concord N H
NORTH 91 SOUTH Brattleboro White River Jct.
0.72 SB
0.81 NB
0.76 NB RET ALL
EMERGENCY STOPPING ONLY
0.62 SB RET(ALL)
0.53 SB
0.64 NB
RAMP 30 M.P.H.
0.68 NB
0.68 NB RET ALL
SOUTH 91 Brattleboro
739' UP RAMP
0.45 NB
SPEED LIMIT 65
MINIMUM 40
RET(ALL)
0.53 NB
0.50 NB
SALVAGE TO MM 0.29 SB
50 M.P.H.
3432' UP RAMP "C"
FORM SINGLE LINE
3221' UP RAMP "C"
RET ALL 0.06 SB
Airport Plainfield NH RIGHT LANE
RET ALL 0.01 SB
Vietnam Veterans Memorial Highway
Connecticut River
0.26 NB
TURN SIGNAL REQUIRED BEFORE CHANGING LANES
0.35 NB
NORTH 91
0.35 NB
BUCKLE UP IT'S THE LAW
RET(ALL)
0.37 NB
0.40 NB
REDUCE SPEED
RET(ALL)
YIELD
845' UP RAMP
REMOVE ASSOC. PVMT MKGS
RAMP 30 M.P.H.
2904' UP RAMP "C"
2693' UP RAMP "C"
SLOWER TRAFFIC KEEP RIGHT
211' UP RAMP "A"
475' UP RAMP "A"
REMOVE ASSOC. PVMT MKGS
STRICTLY ENFORCED
RET ALL 0.42 NB
0.08 NB
WELCOME CENTER NEXT RIGHT
SPEED LIMIT 65
MINIMUM 40
0.20 NB
0.20 NB
Welcome To VERMONT
WELCOME TO VERMONT GREEN MOUNTAIN STATE
STATE LINE ENTERING VERMONT
0.08 NB
R&S
RET ALL
WELCOME CENTER NEXT RIGHT
NORTH 91 White River Jct. RIGHT LANE
RET ALL
0.15 NB
PLOTTED: 14-NOV-2000
SIGN LEGEND
R EXISTING ITEM TO BE REMOVED
R&S EXISTING ITEM TO BE REMOVED & SALVAGED
S SALVAGED SIGN TO BE INSTALLED
RET EXISTING ITEM TO BE RETAINED
N NEW ITEM
ALL SIGNS WILL BE NEW UNLESS OTHERWISE NOTED
NEW SIGNS
INTERCHANGE #10
HARTFORD
I-89 & I-91 INTERCHANGE
0 150 300
SCALE : 2 /3 IN = 100 FT
ta00891m. i
/trnsf/87a008/ La008i91. dgn
PREPARED BY LCS DATE 11/92
CHECKED BY DATE
DESIGN SUPERVISOR DLP DATE 11/92
PROJ.
HARTFORD-SHARON-ROYALTON
IM IR 089-1(8)
TRAFFIC SHEET NO. OF
SHEET 197 OF 260 SHEETS