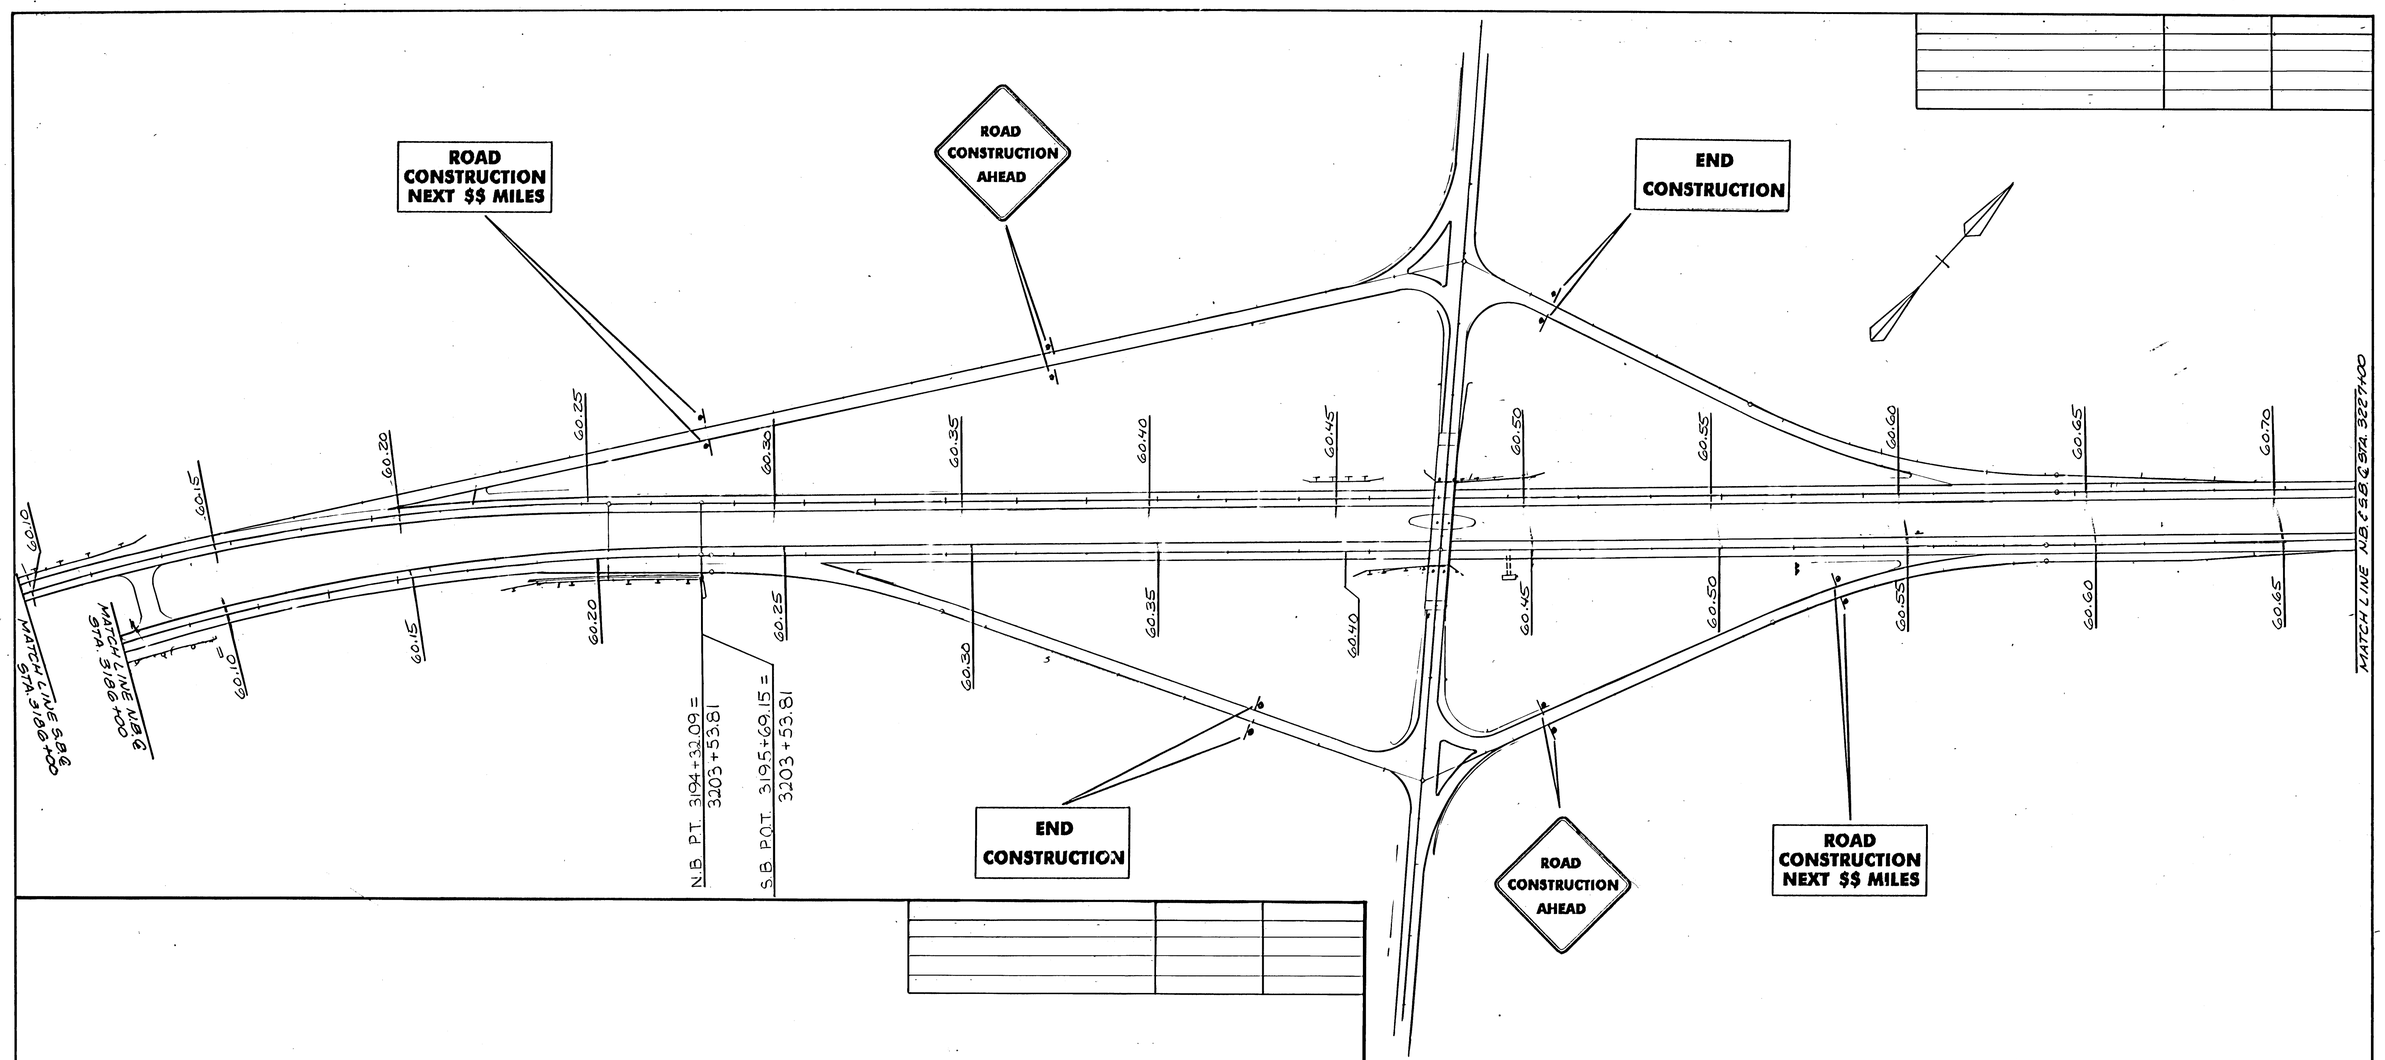

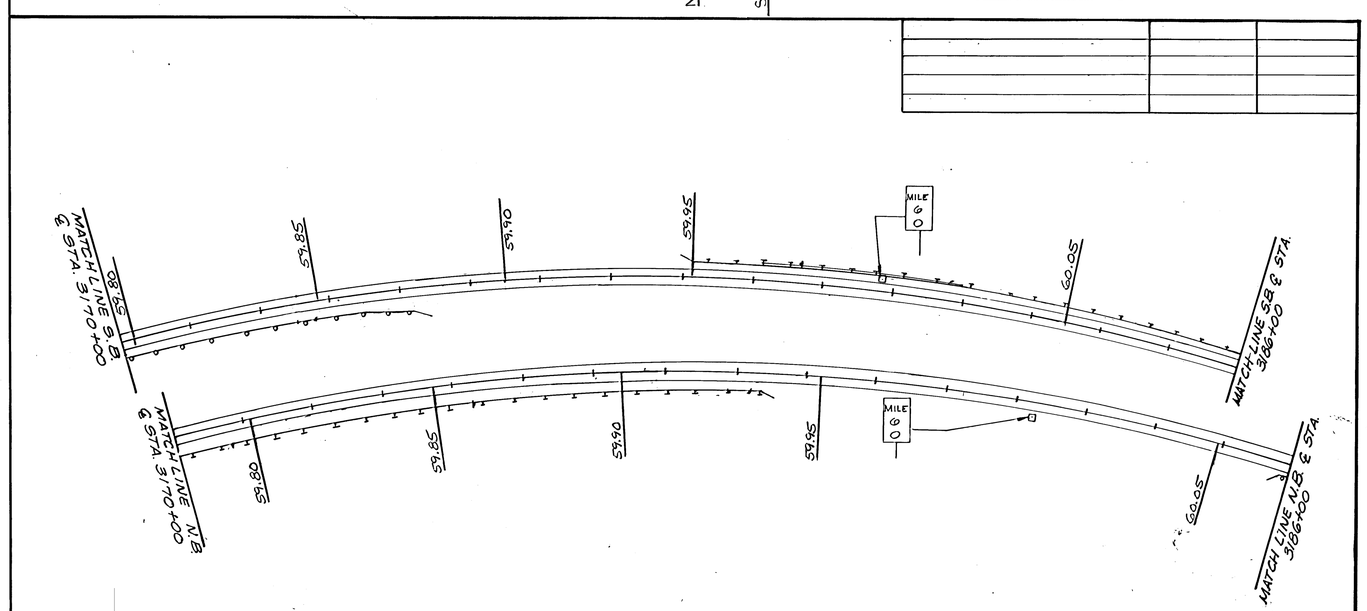

HARTLAND INTERCHANGE
CONSTRUCTION SIGNING

VERMONT AGENCY OF TRANSPORTATION

SAFETY PROJECT
SPRINGFIELD - HARTFORD
IR 91 - 1(20)

SCALE	DATE	SHEET
		42 OF 133

IN CHARGE OF: _____ DATE: _____
DESIGNED BY: _____ DETAILED BY: _____
CHECKED BY: _____