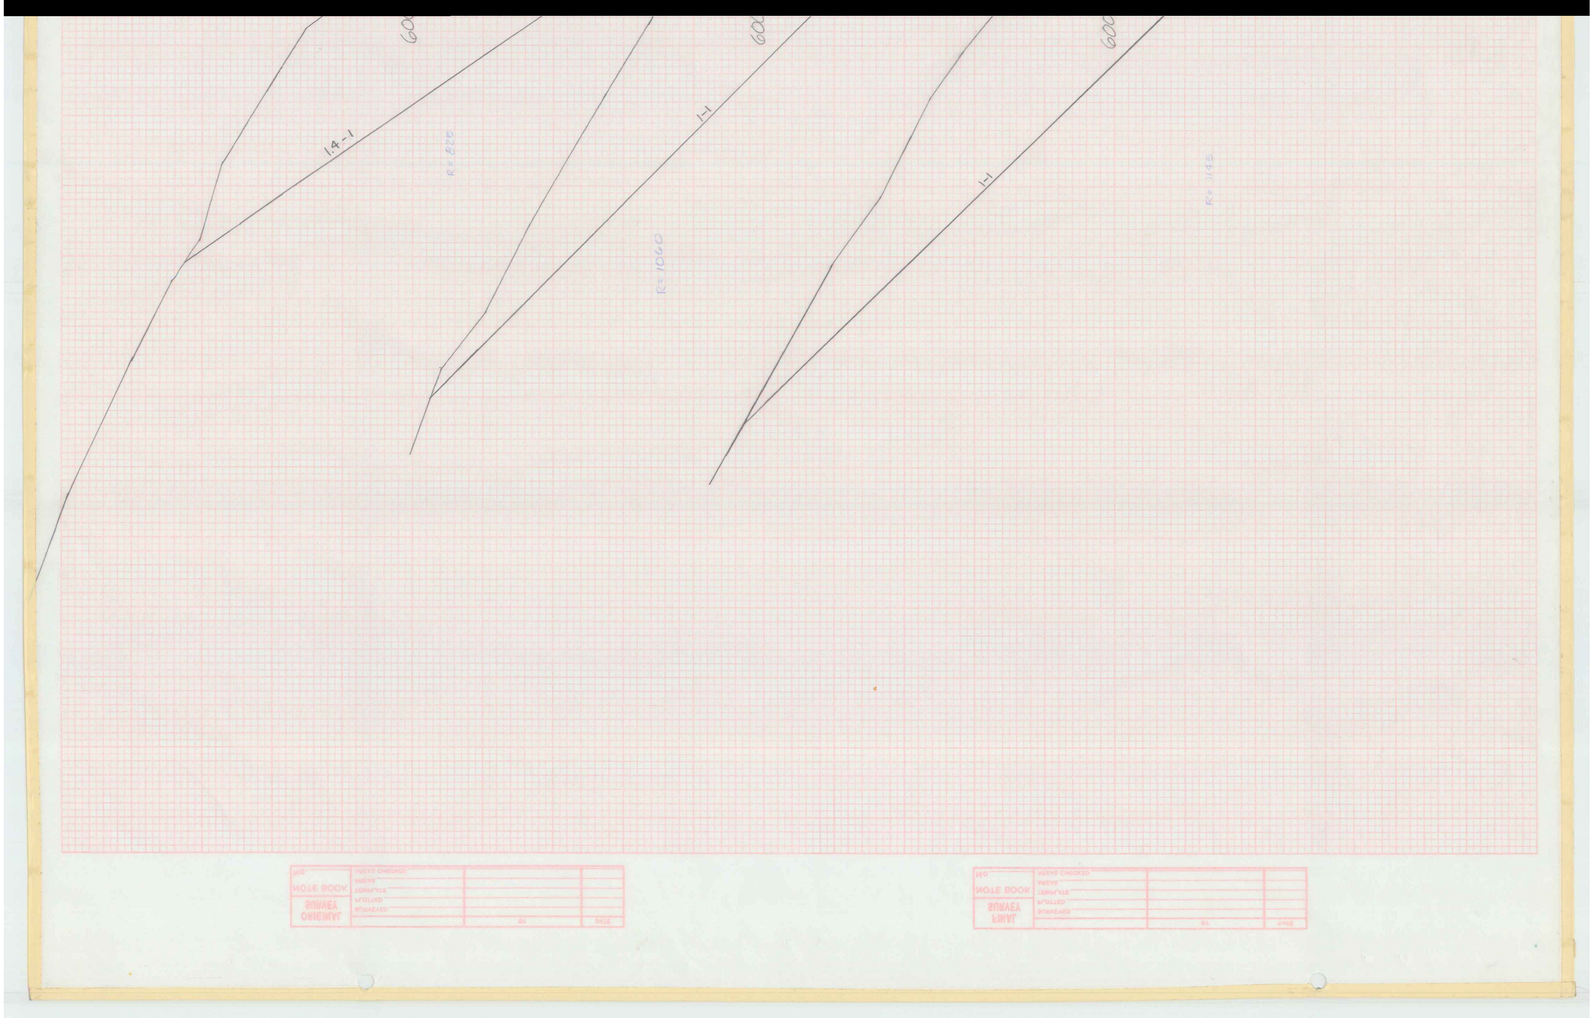
14-1
1-1
1-1