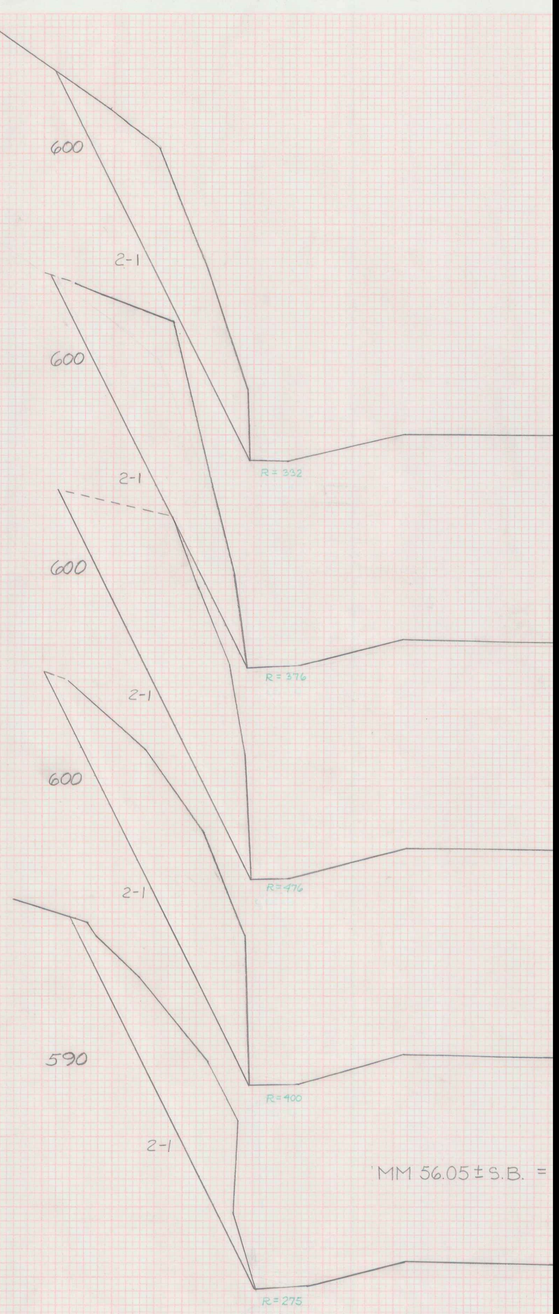

600
2-1
600
2-1
600
2-1
600
2-1
590
2-1
R=332
R=376
R=476
R=400
R=275
MM 56.05 ± S.B. =