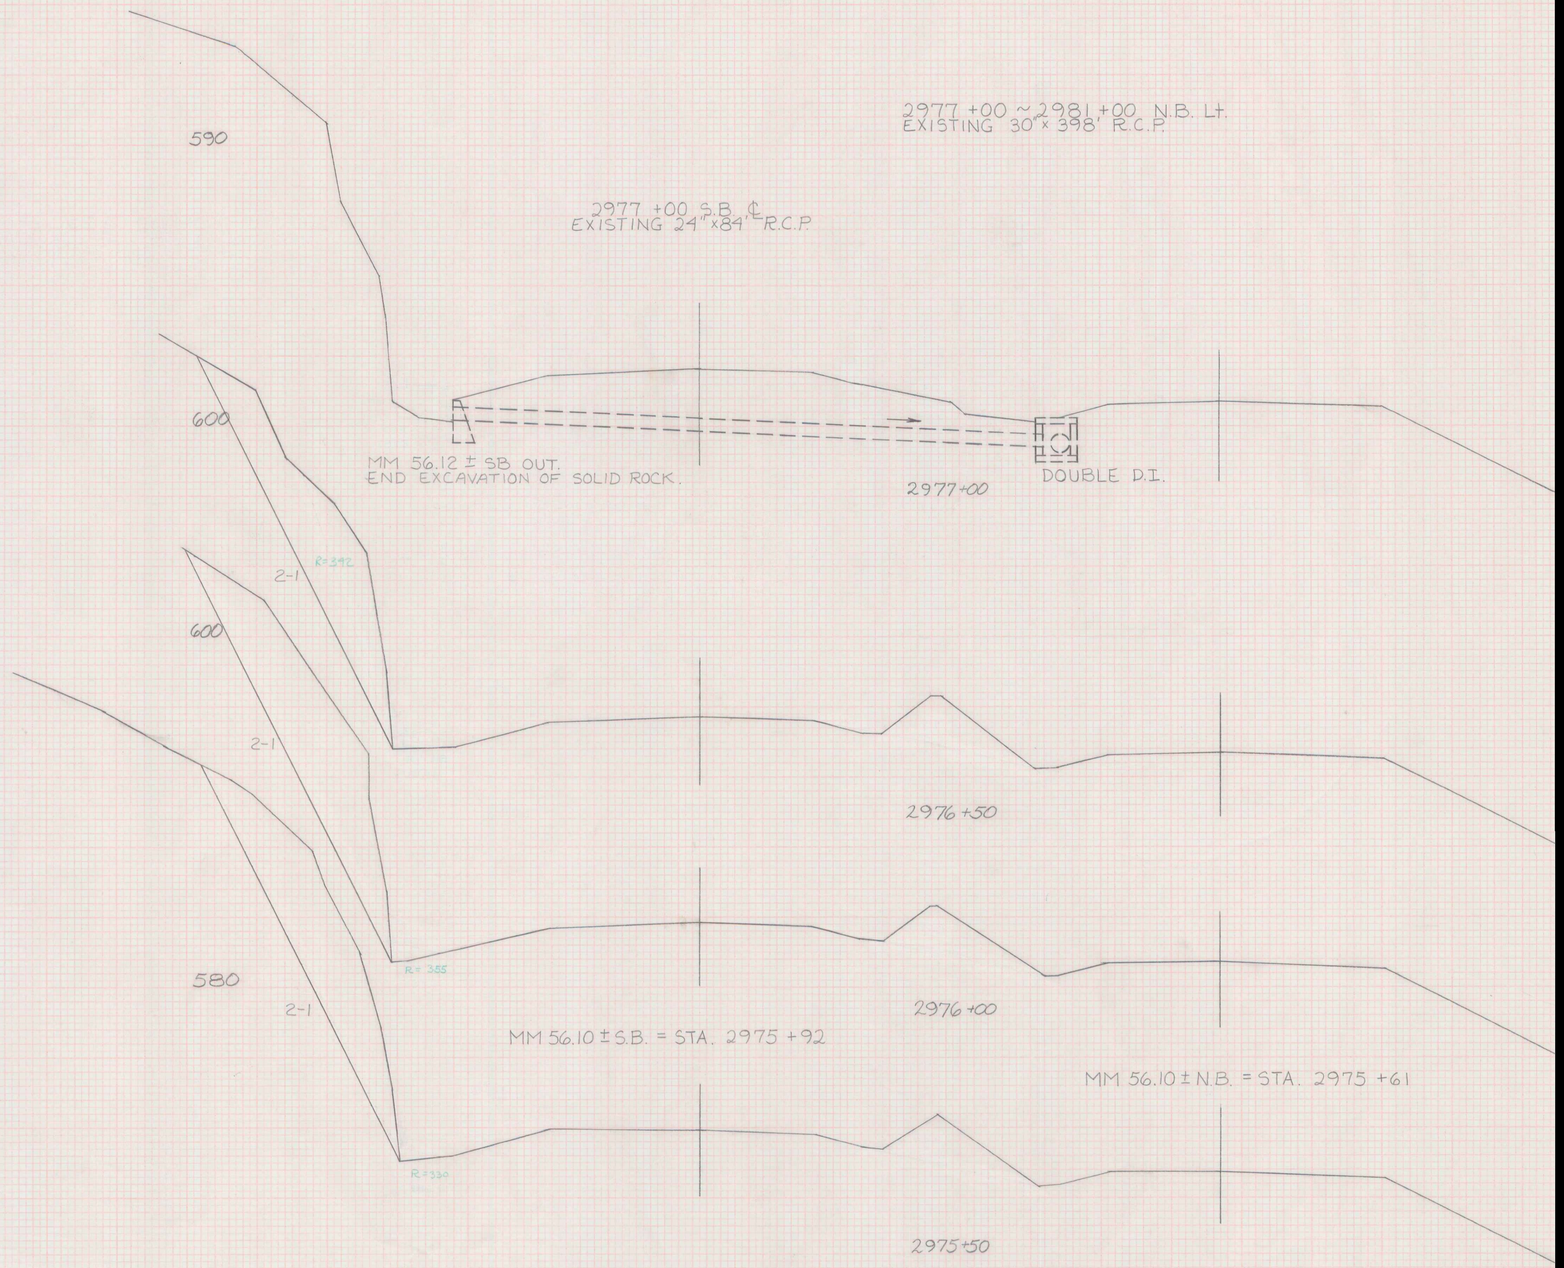

590
600
600
580
2-1
2-1
2-1
R=392
R=385
R=330
2977 +00 S.B. ℄
EXISTING 24" x 84" R.C.P.
2977 +00 ~ 2981 +00 N.B. Lt.
EXISTING 30" x 398' R.C.P.
MM 56.12 ± SB OUT.
END EXCAVATION OF SOLID ROCK.
2977+00
DOUBLE D.I.
2976 +50
2976 +00
MM 56.10 ± S.B. = STA. 2975 +92
MM 56.10 ± N.B. = STA. 2975 +61
2975+50