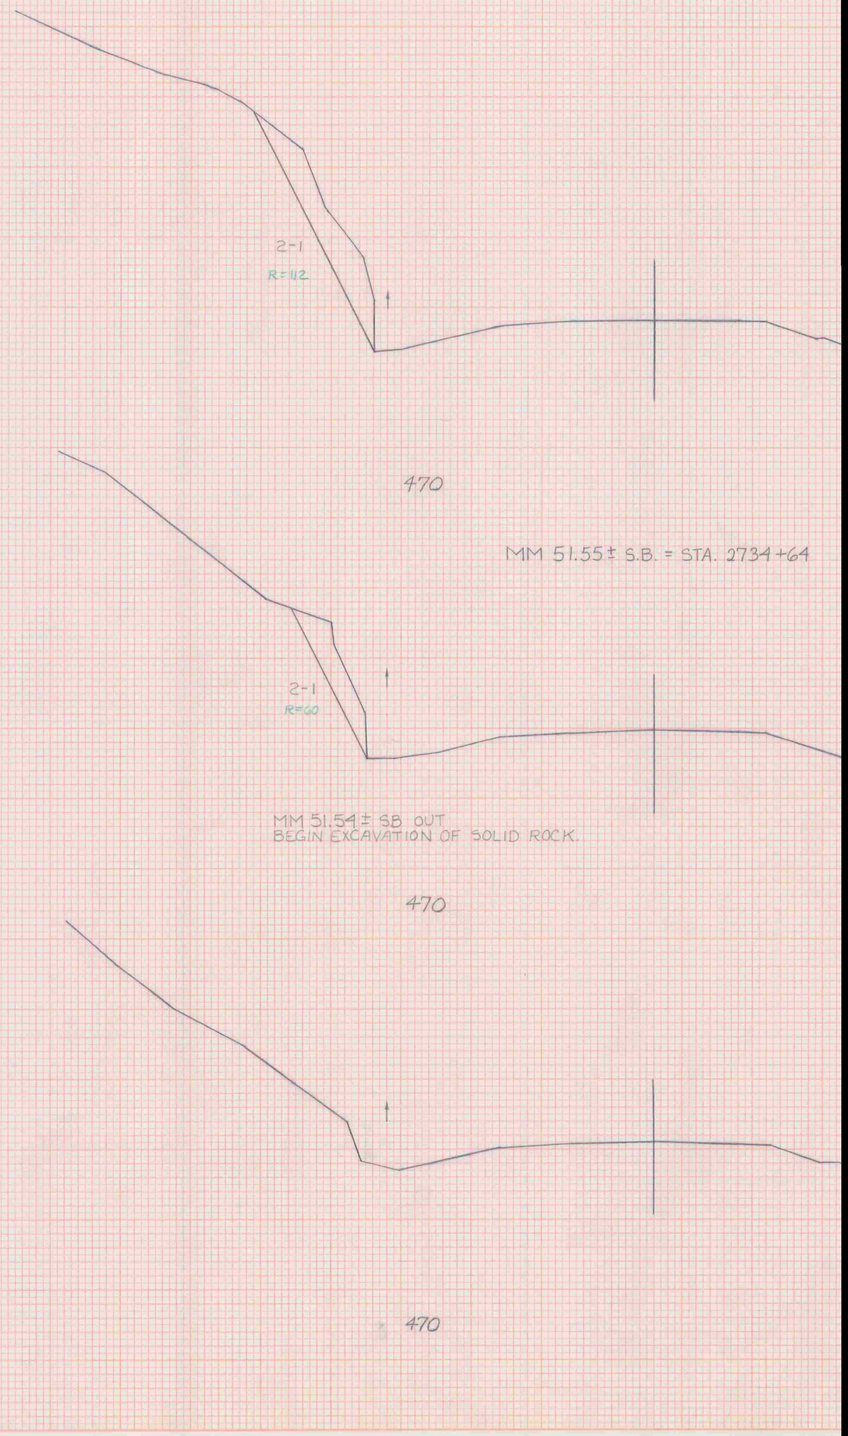

2-1
R=112
470
MM 51.55± S.B. = STA. 2734+64
2-1
R=60
MM 51.54± SB OUT
BEGIN EXCAVATION OF SOLID ROCK.
470
470