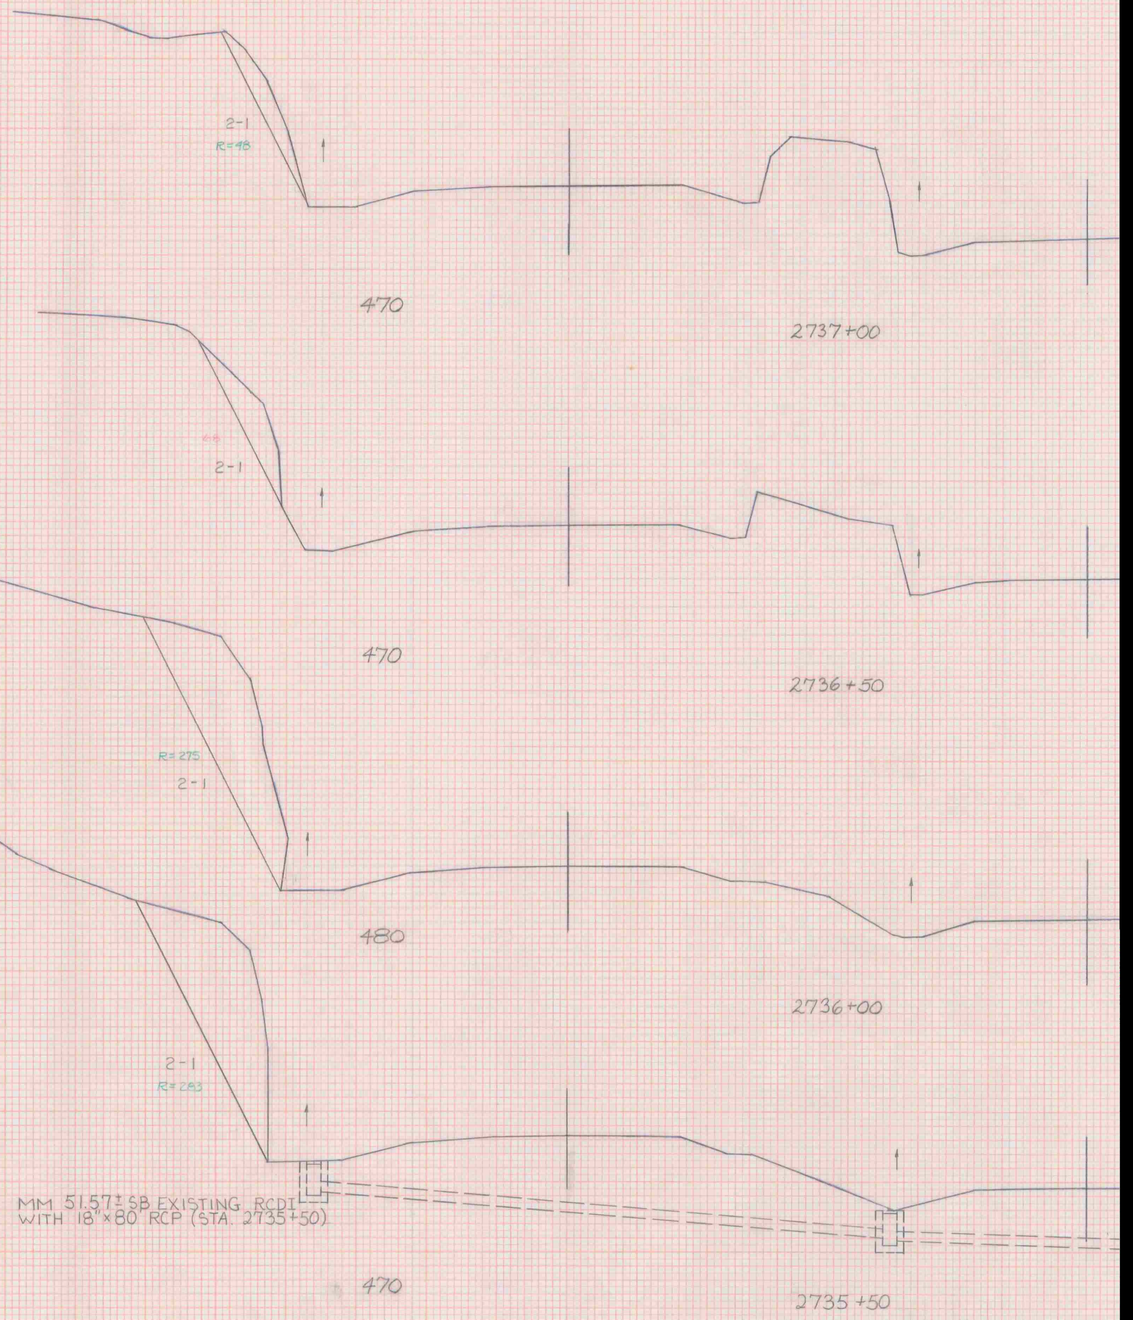


FINAL SURVEY — SURVEYED, PLOTTED, TEMPLATE, AREAS CHECKED — BY — DATE

ORIGINAL SURVEY — SURVEYED, PLOTTED, TEMPLATE, AREAS CHECKED — BY — DATE