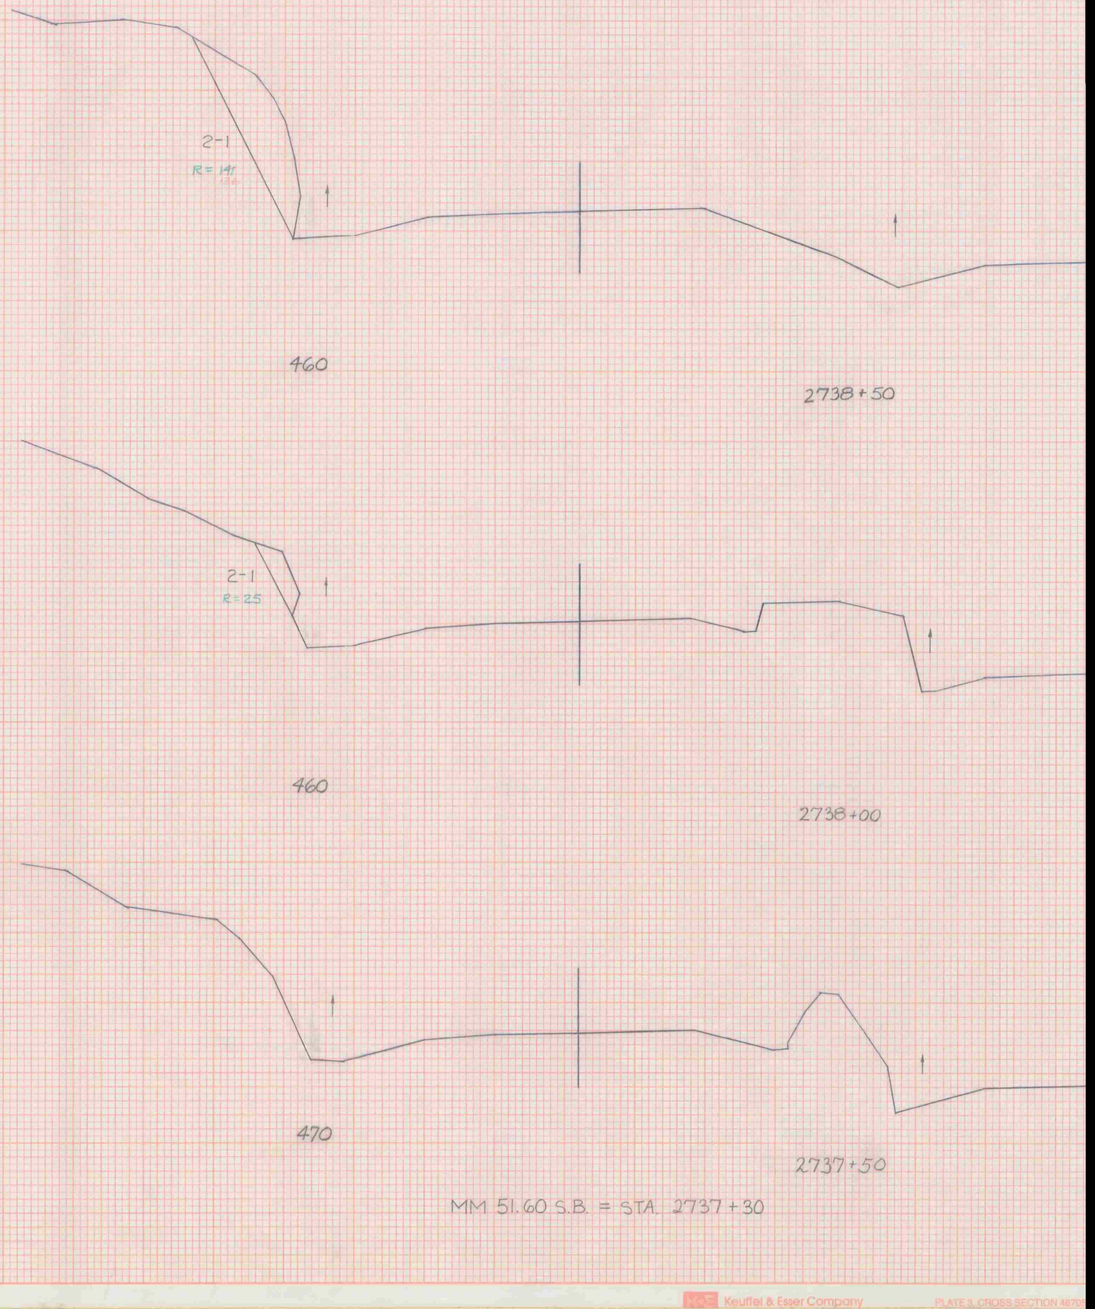


FINAL SURVEY
NOTE BOOK
NO.
SURVEYED PLOTTED TEMPLATE AREAS CHECKED
DATE
BY
ORIGINAL SURVEY
NOTE BOOK
NO.
PLOTTED PLOTTED TEMPLATE AREAS CHECKED
DATE
BY