


FINAL SURVEY
NOTE BOOK
No.
SURVEYED
PLOTTED
TRANS.ATE
AREAS CHECKED
BY
DATE

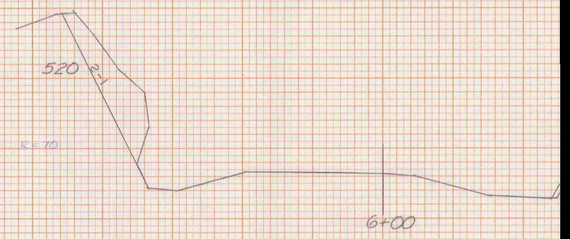

5+50 LT
BEGIN EXCAVATION OF SOLID ROCK.

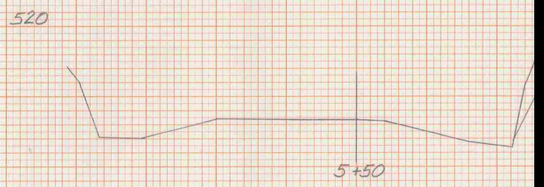

ORIGINAL SURVEY
NOTE BOOK
No.
SURVEYED
PLOTTED
TRANS.ATE
AREAS CHECKED
BY
DATE

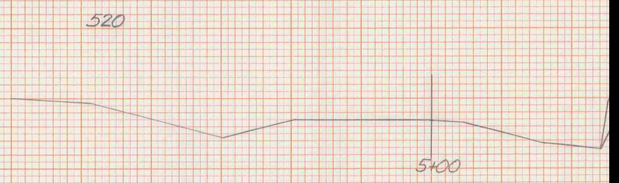

4+7
BEG

