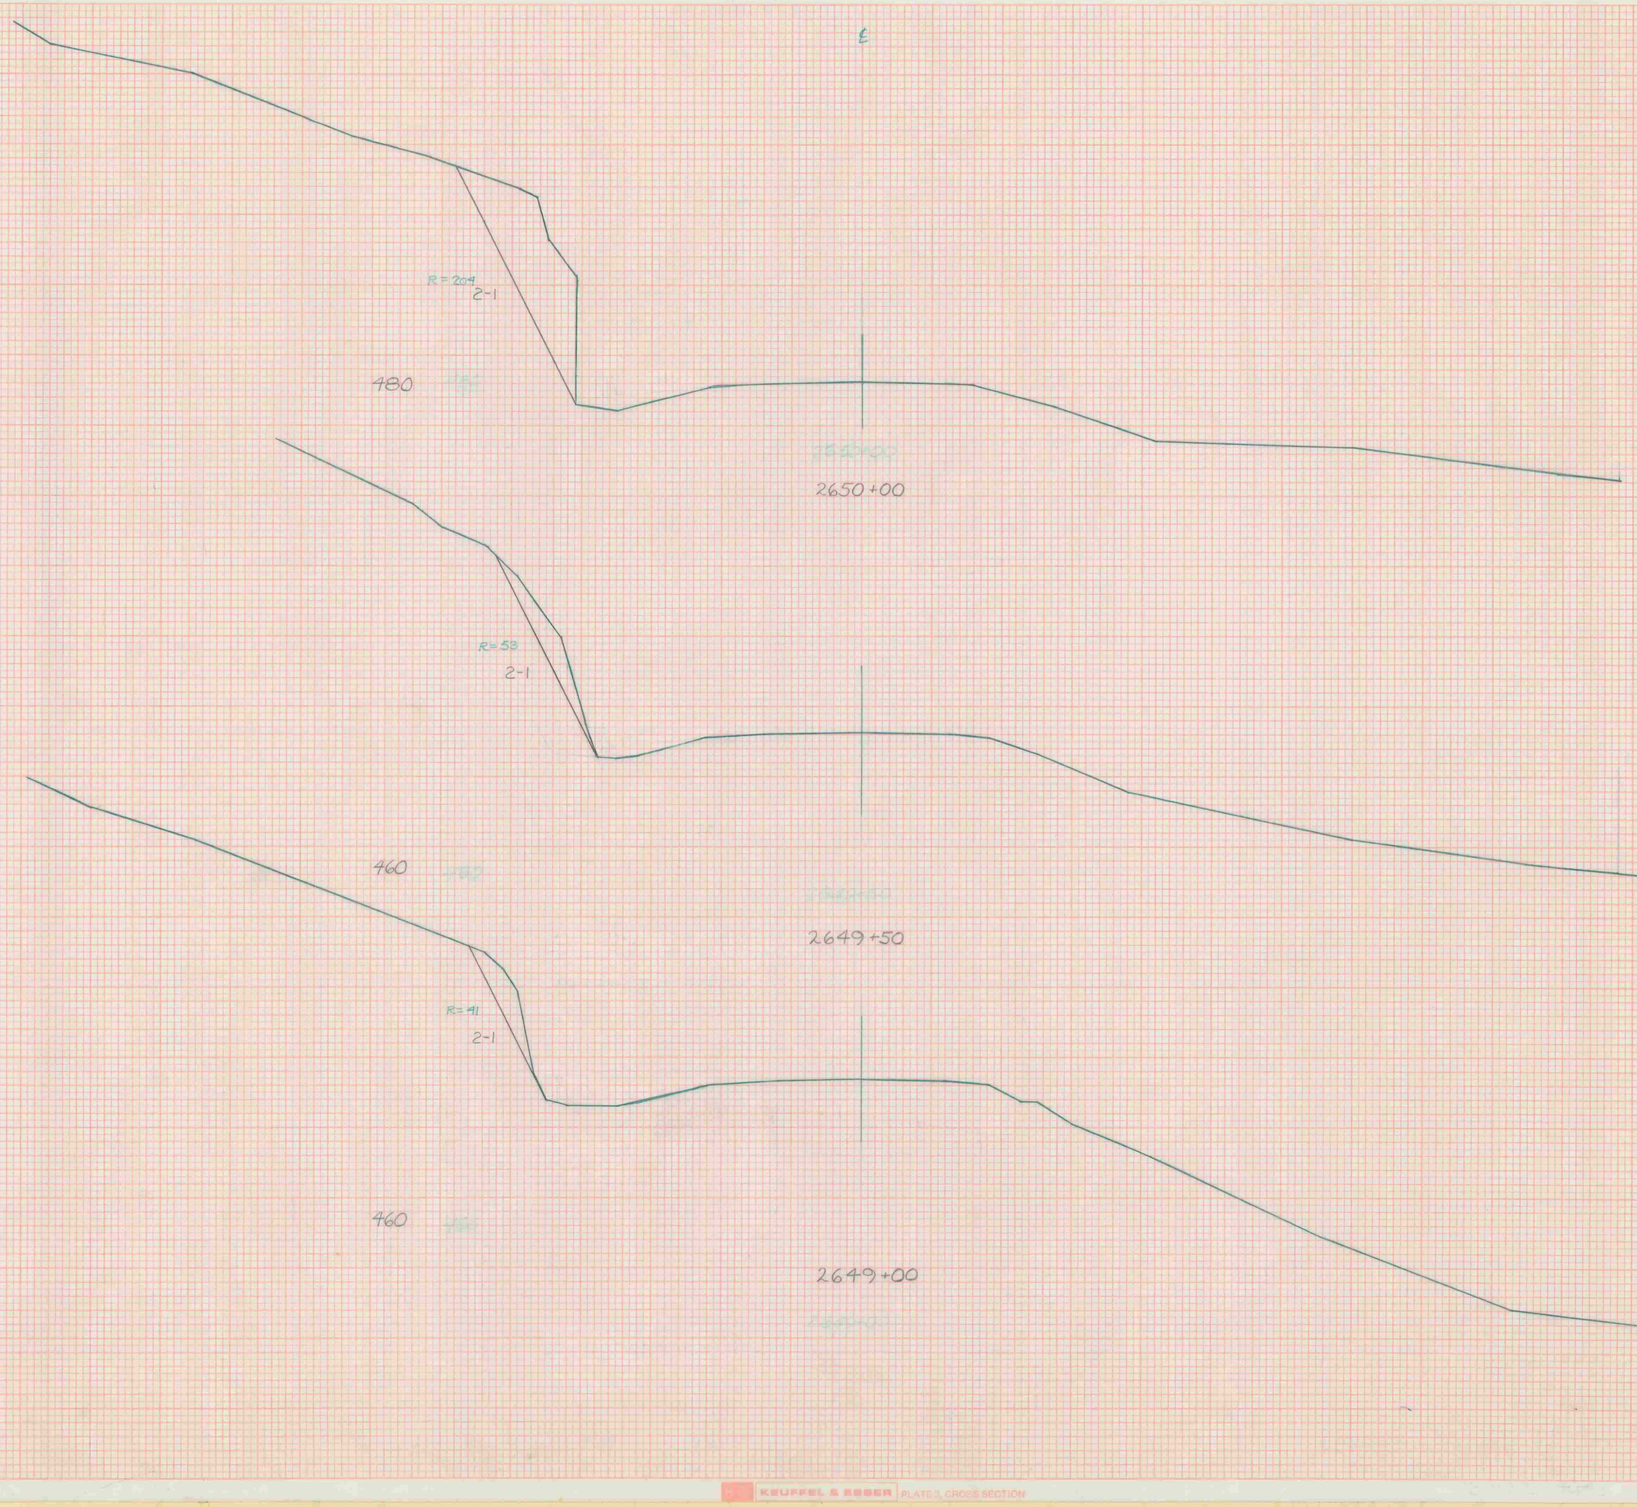


FINAL SURVEY
SURVEYED
PLOTTED
TEMPLATE
AREAS
NOTE BOOK
CHKD
DATE
BY
DETAILS EXECUTED

ORIGINAL SURVEY
SURVEYED
PLOTTED
TEMPLATE
AREAS
NOTE BOOK
CHKD
DATE
BY

MM. 49.92 MM. 50.05
STA. 2649+0 STA. 2650+0
TOWN SPRINGFIELD-HARTFORD
PROJECT IR NO. 091-1(20)
SHEET 76 OF 133 SHEETS
HORIZ. AND VERT. SCALE:
1" = 10'
DATE: JAN. '90