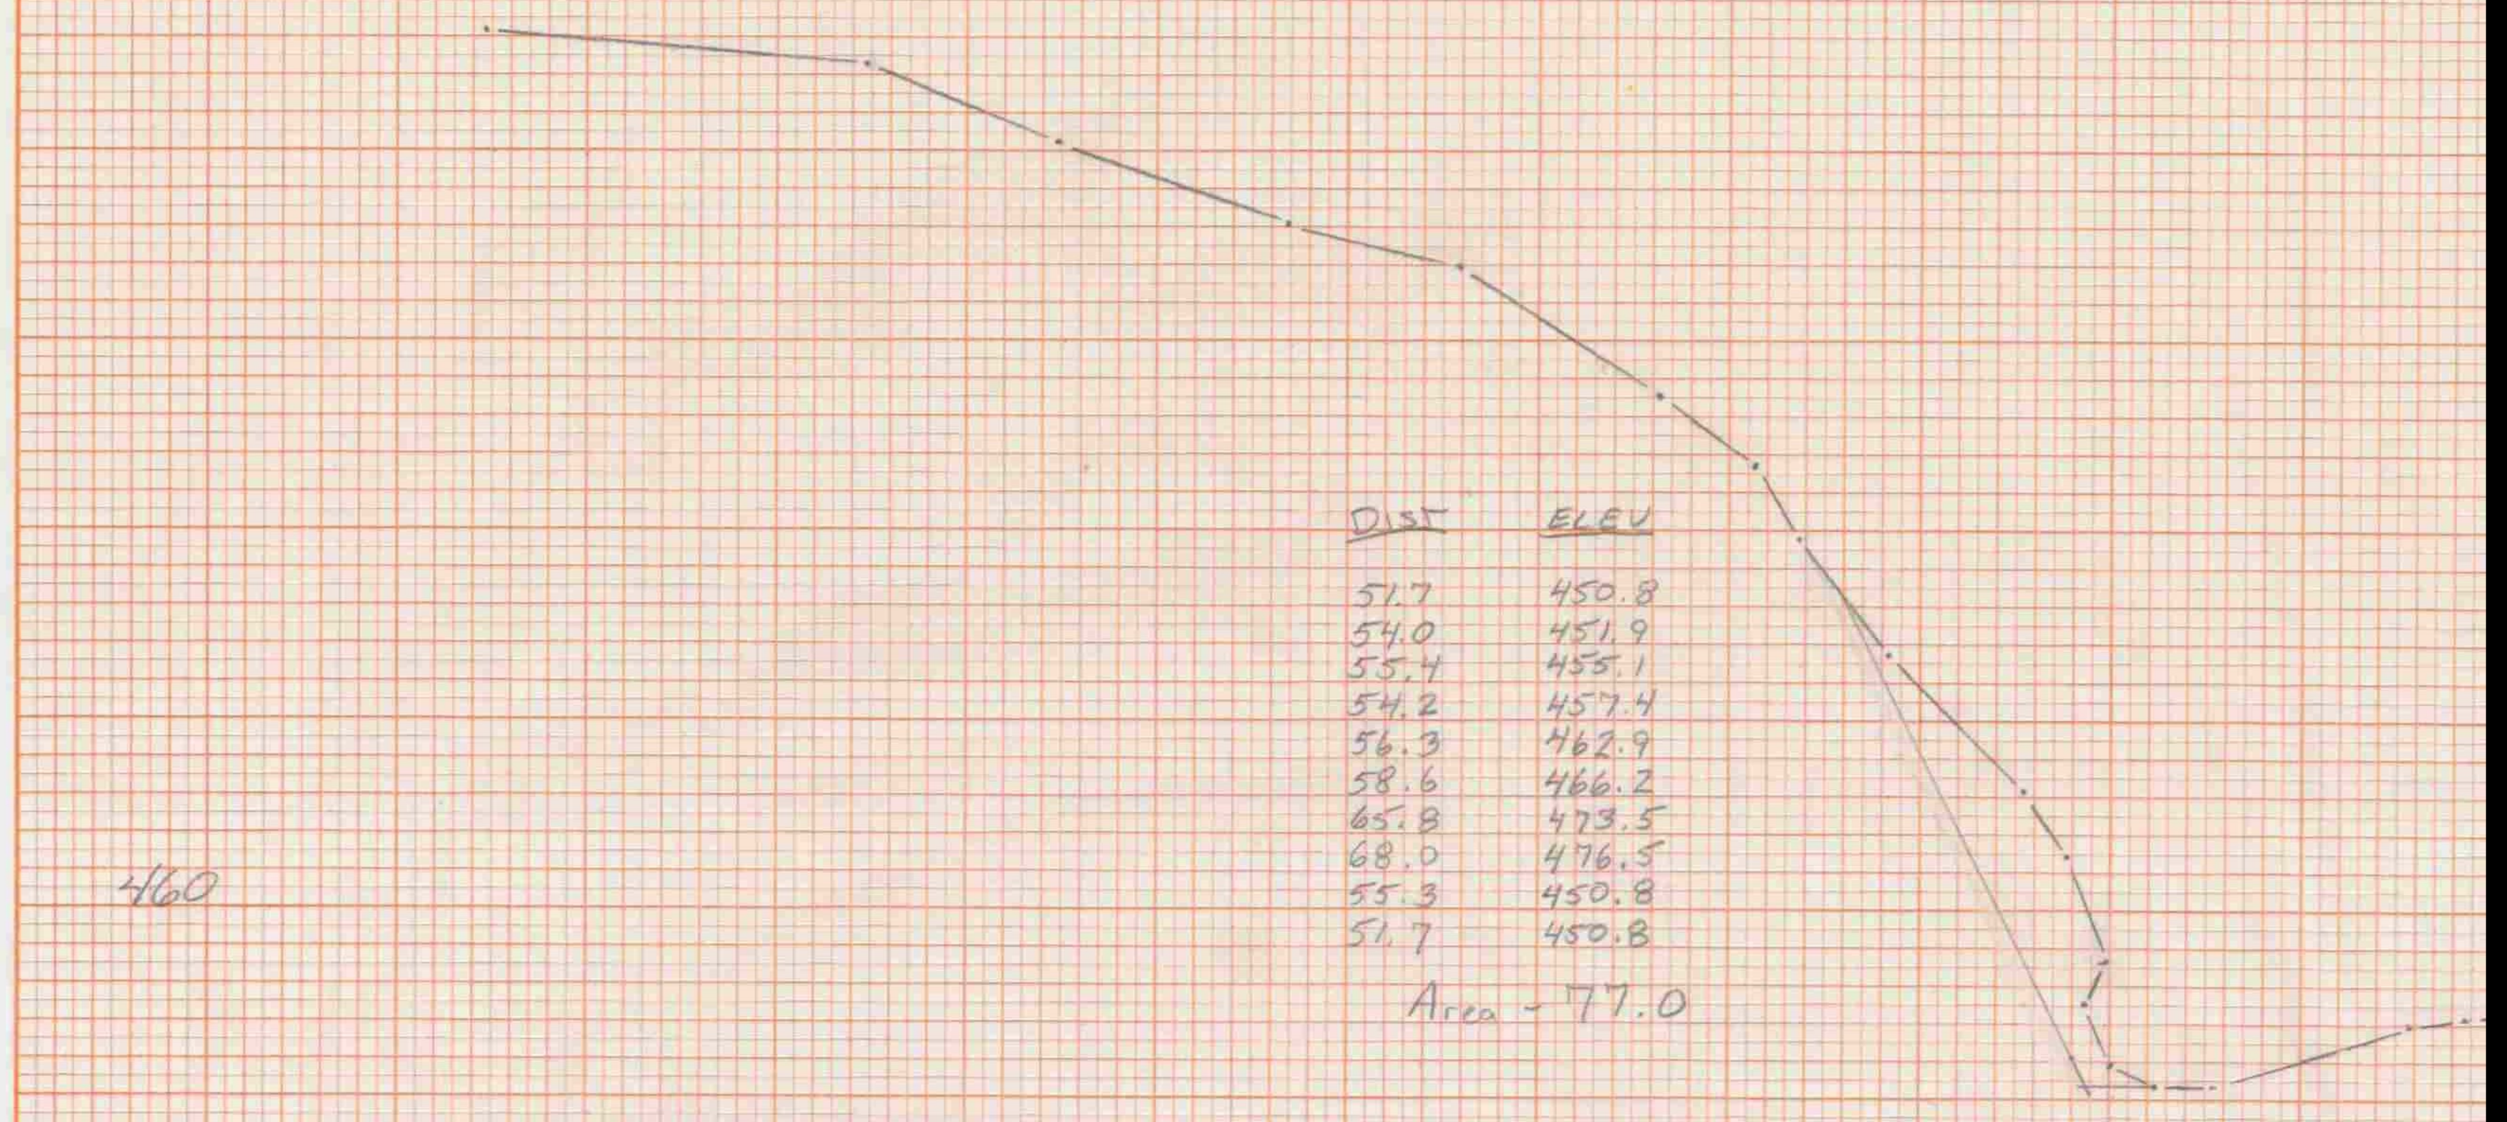

DIST	ELEV
51.7	450.8
54.0	451.9
55.4	455.1
54.2	457.4
56.3	462.9
58.6	466.2
65.8	473.5
68.0	476.5
55.3	450.8
51.7	450.8

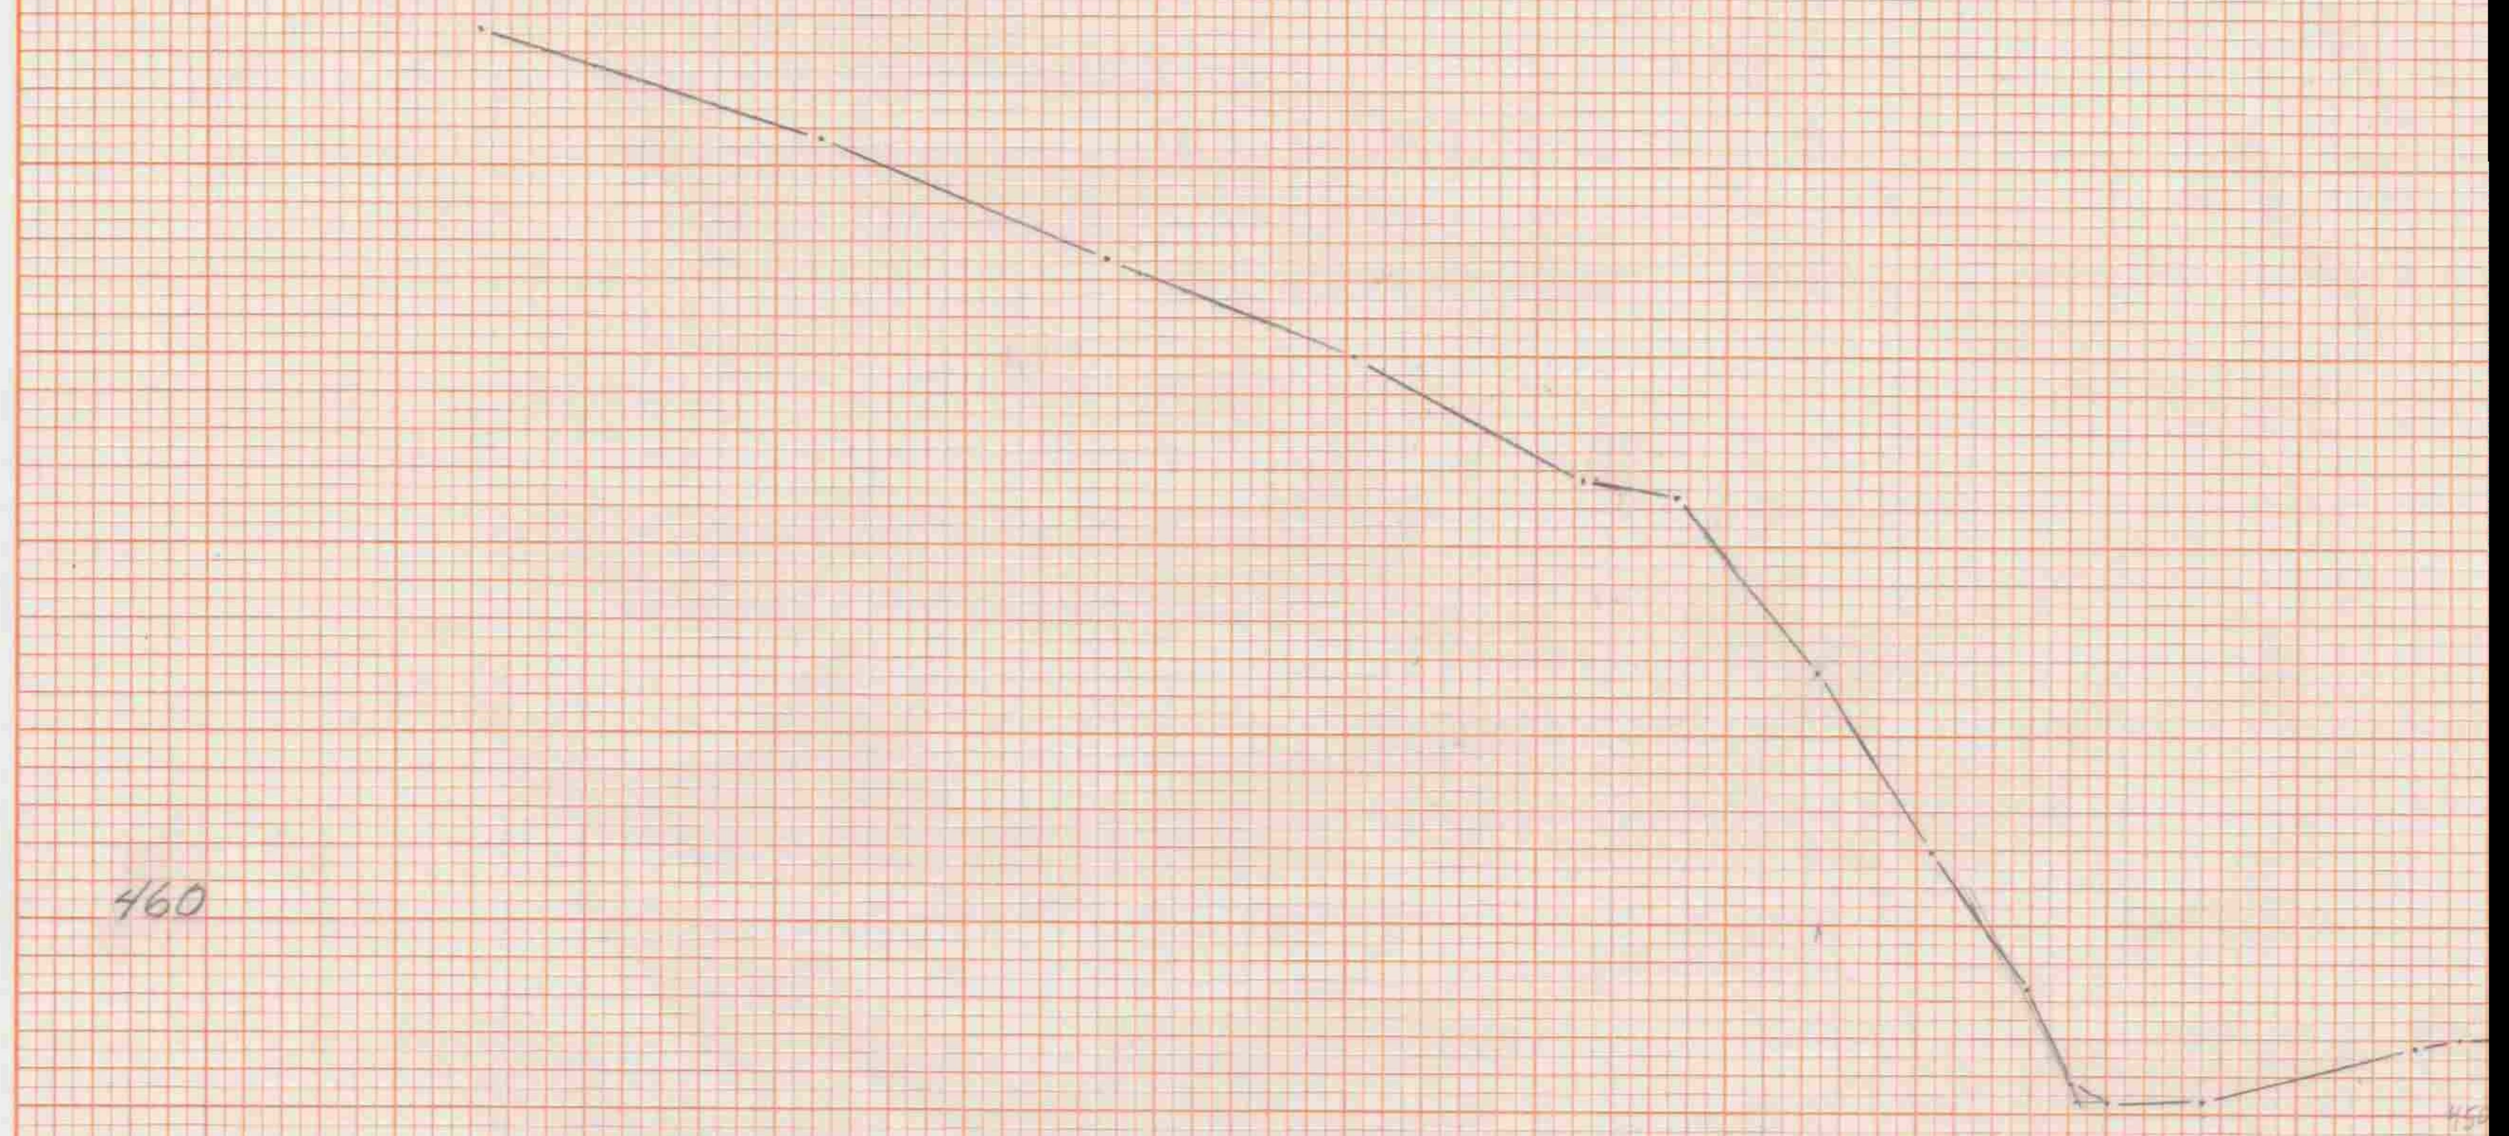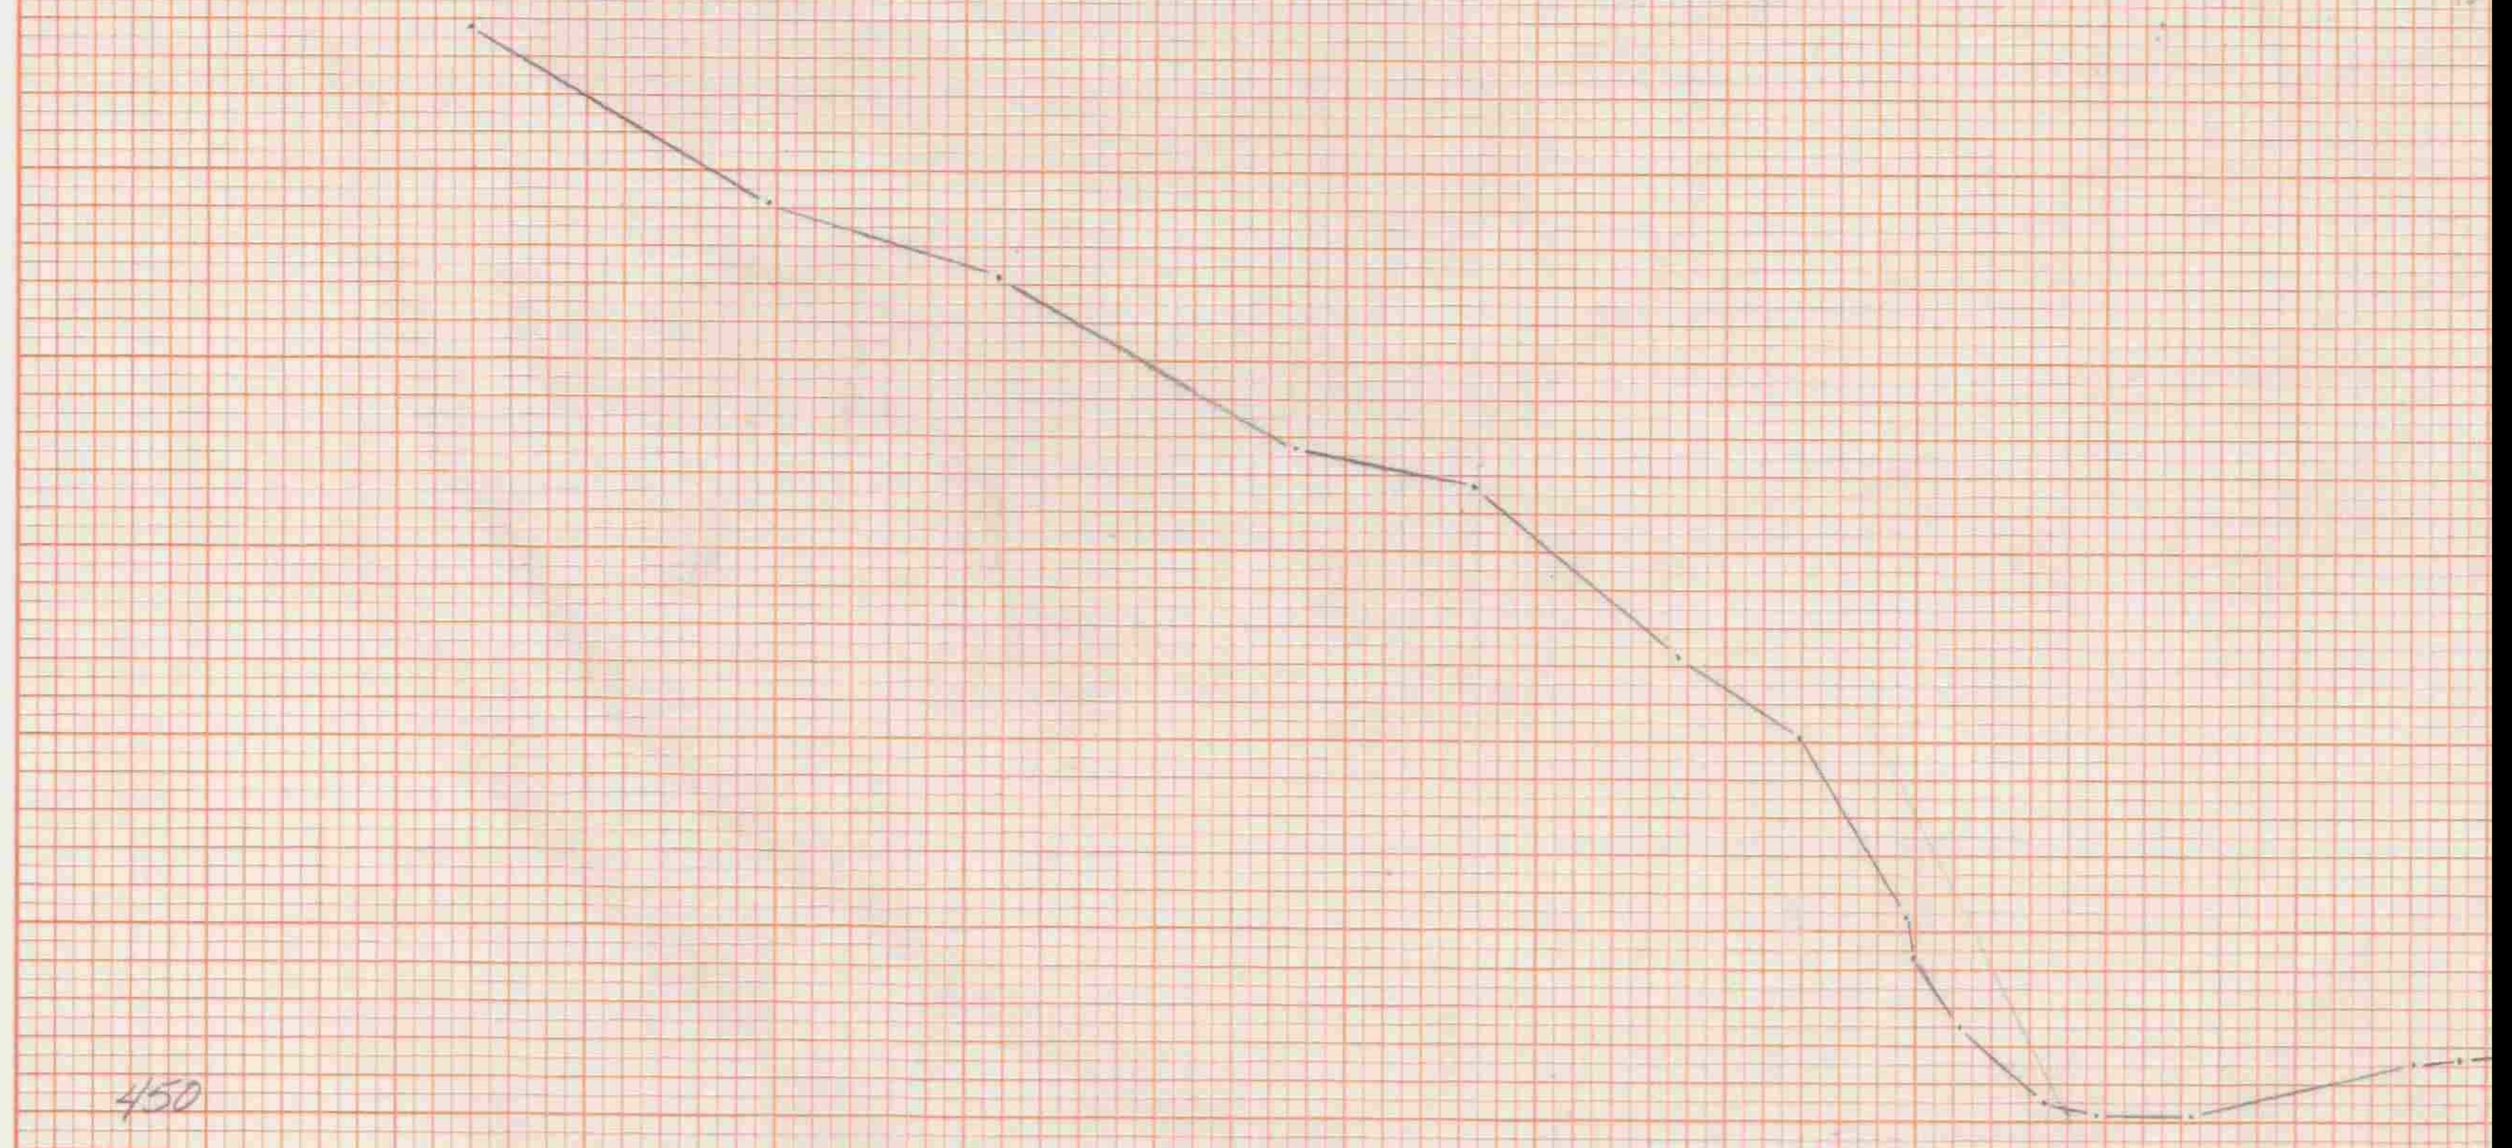Area - 77.0