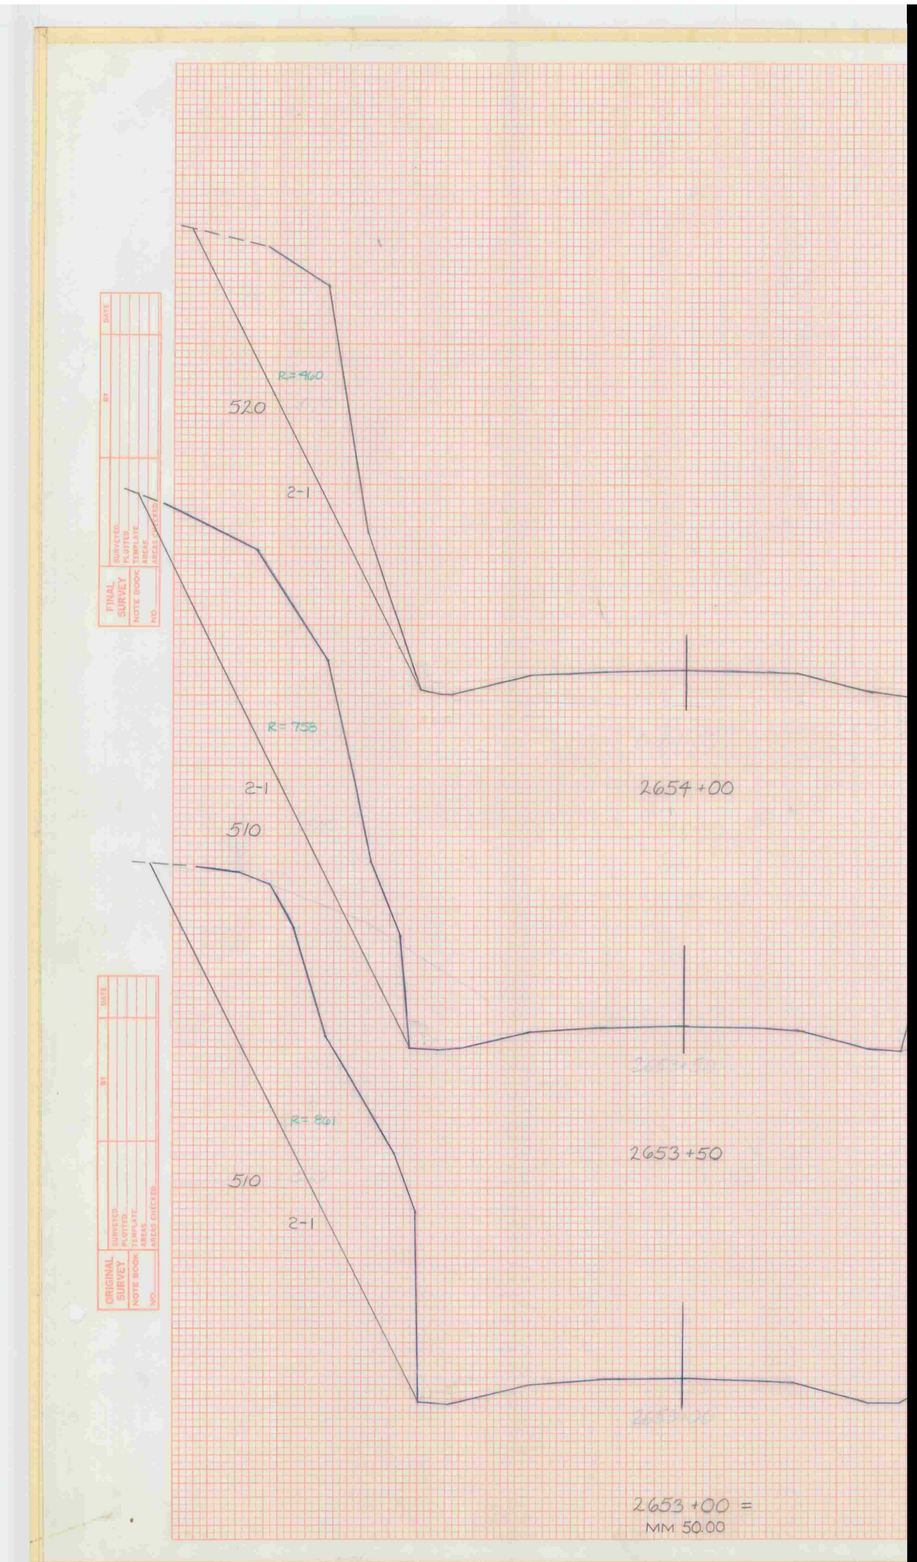

FINAL SURVEY
SURVEYED:
PLOTTED:
TEMPLATE:
AREAS:
CHECKED:
NOTE BOOK
NO.
BY
DATE
R=960
520
2-1
R=758
2-1
510
2654+00
R=861
510
2-1
2653+50
2653+00 =
MM 50.00