


FINAL SURVEY
 CHECKED BY _____ DATE _____
 SURVEYED BY _____
 DRAWN BY _____
 AREA _____
 LABELS CHECKED _____

ORIGINAL SURVEY
 CHECKED BY _____ DATE _____
 SURVEYED BY _____
 DRAWN BY _____
 AREA _____
 LABELS CHECKED _____

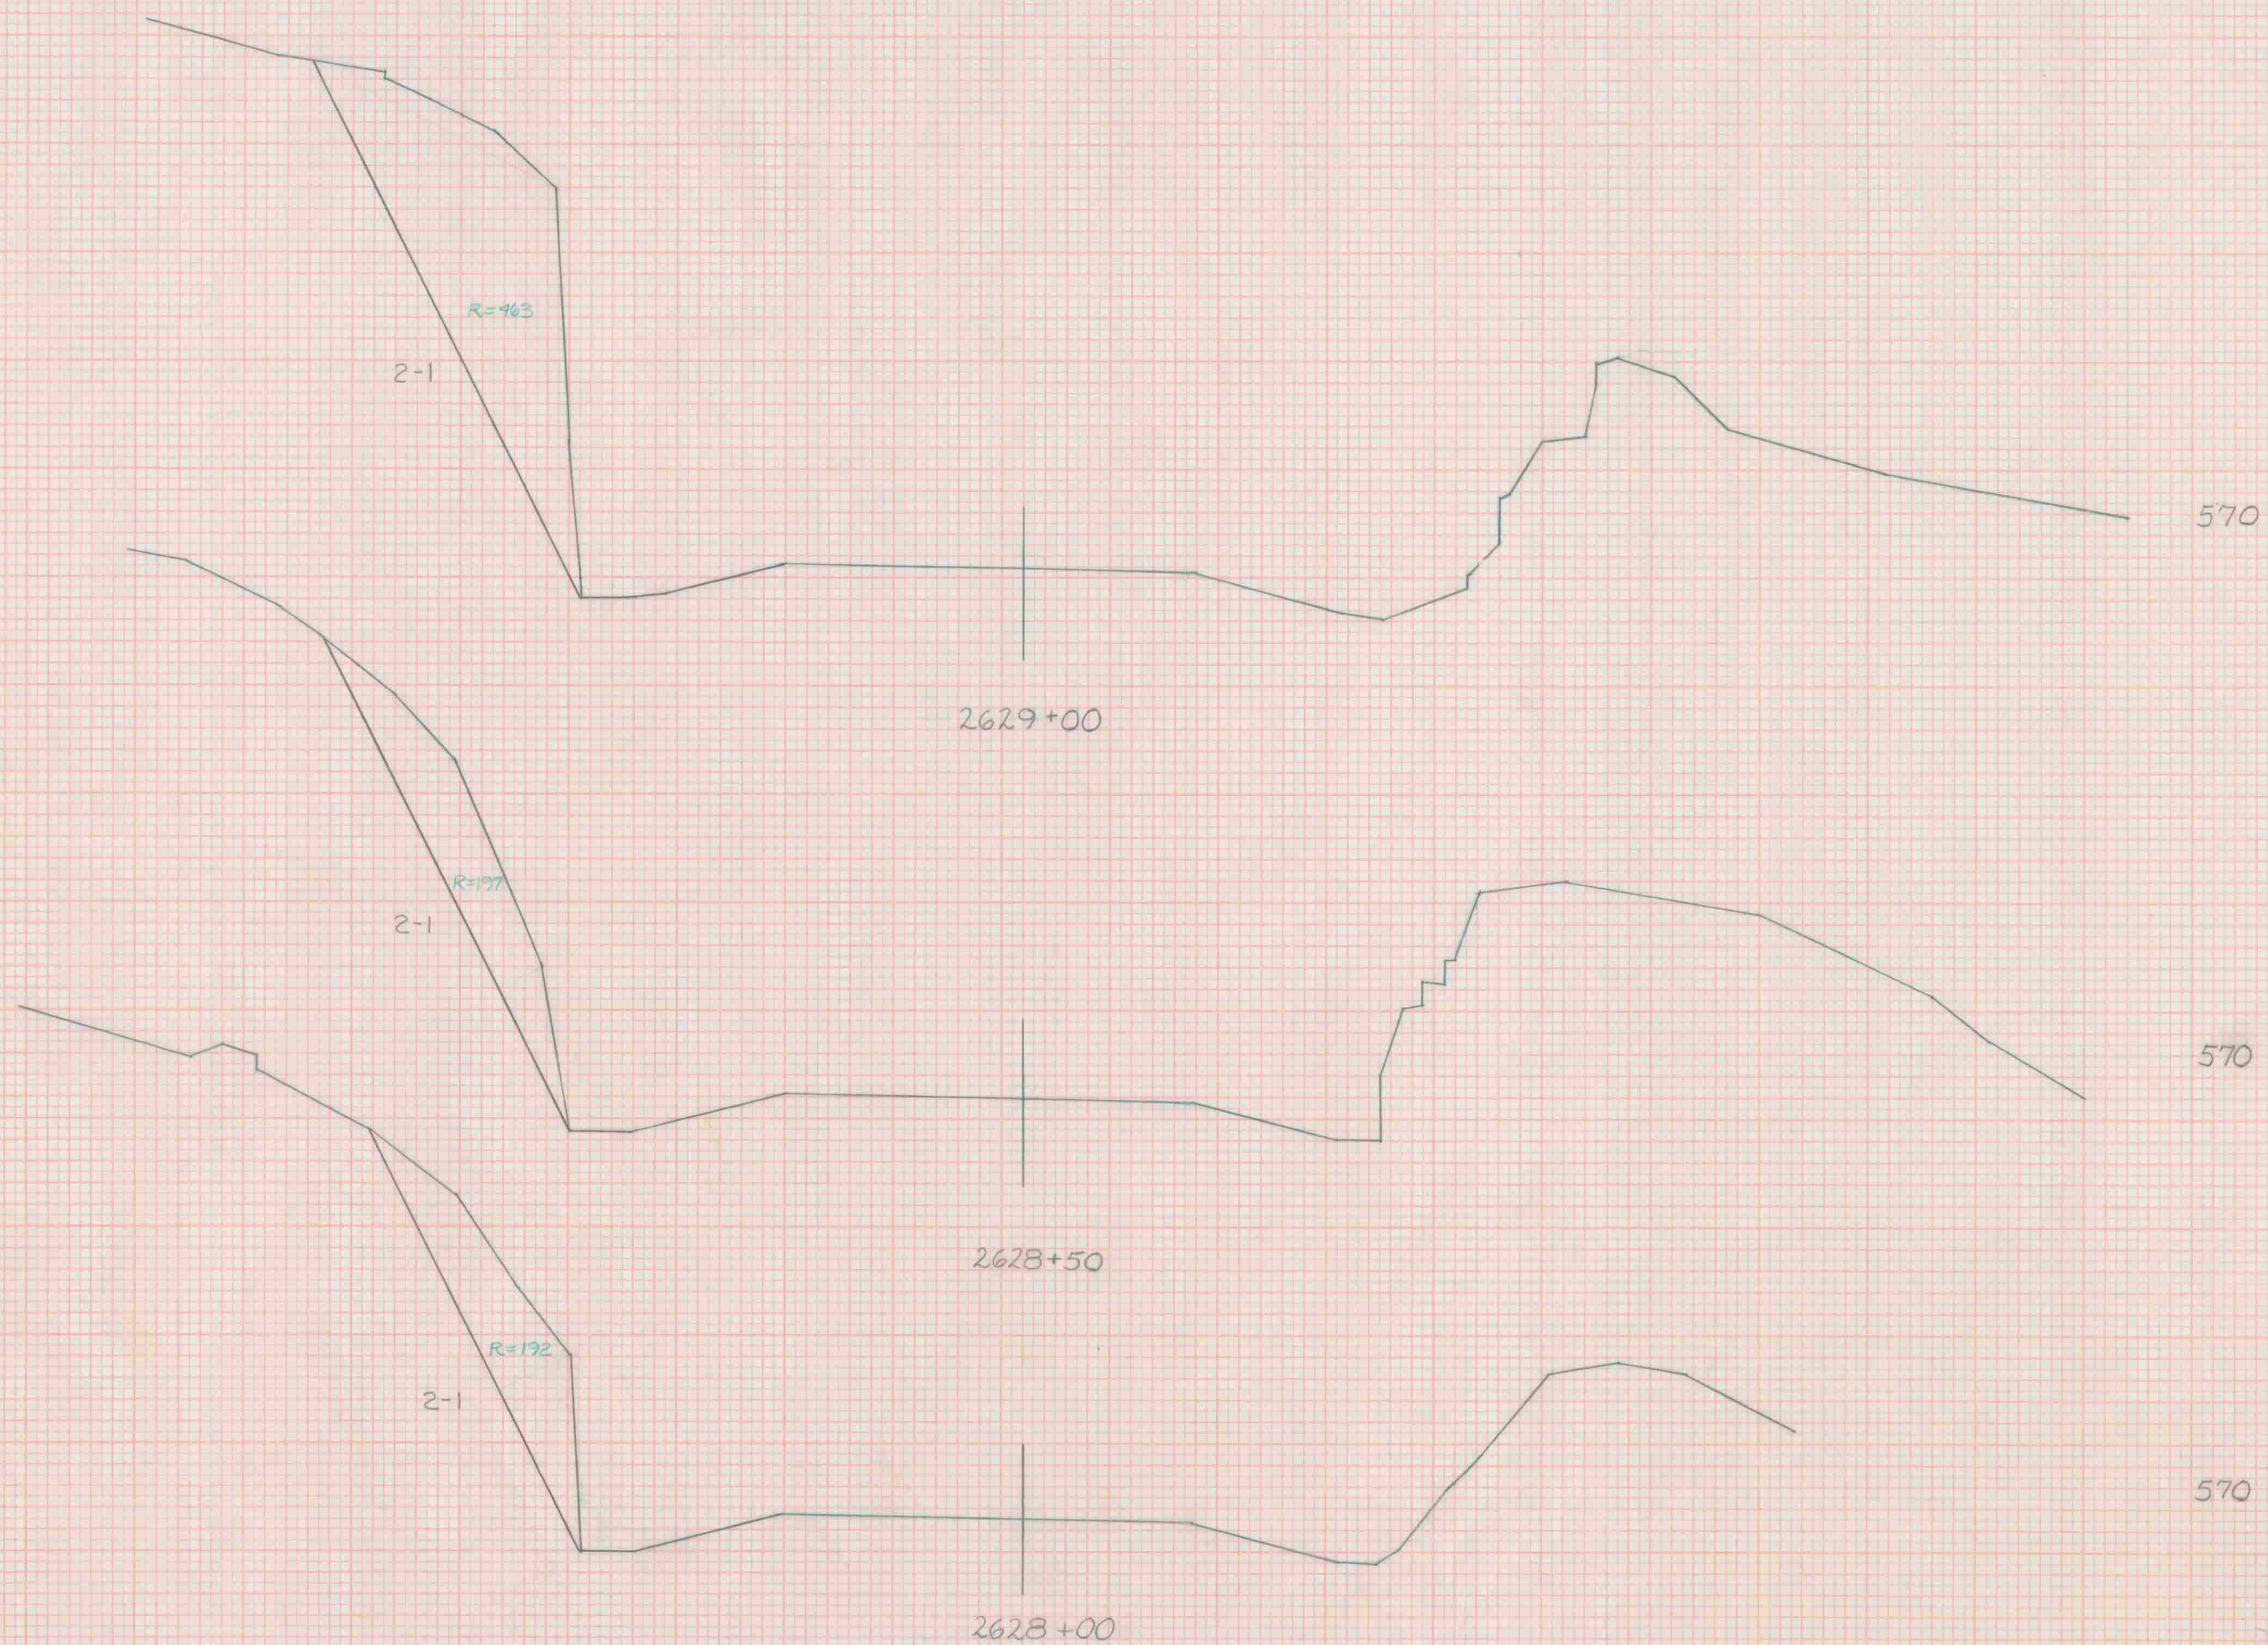

MM 49.51 MM 49.59
 STA. 2628+00 STA. 2629+00
 TOWN SPRINGFIELD-HARTFORD
 PROJECT IR NO 091-1(20)
 SHEET 83 OF 133 SHEETS
 HORIZ. AND VERT. SCALE
 1" = 10'
 DATE: JAN. '90