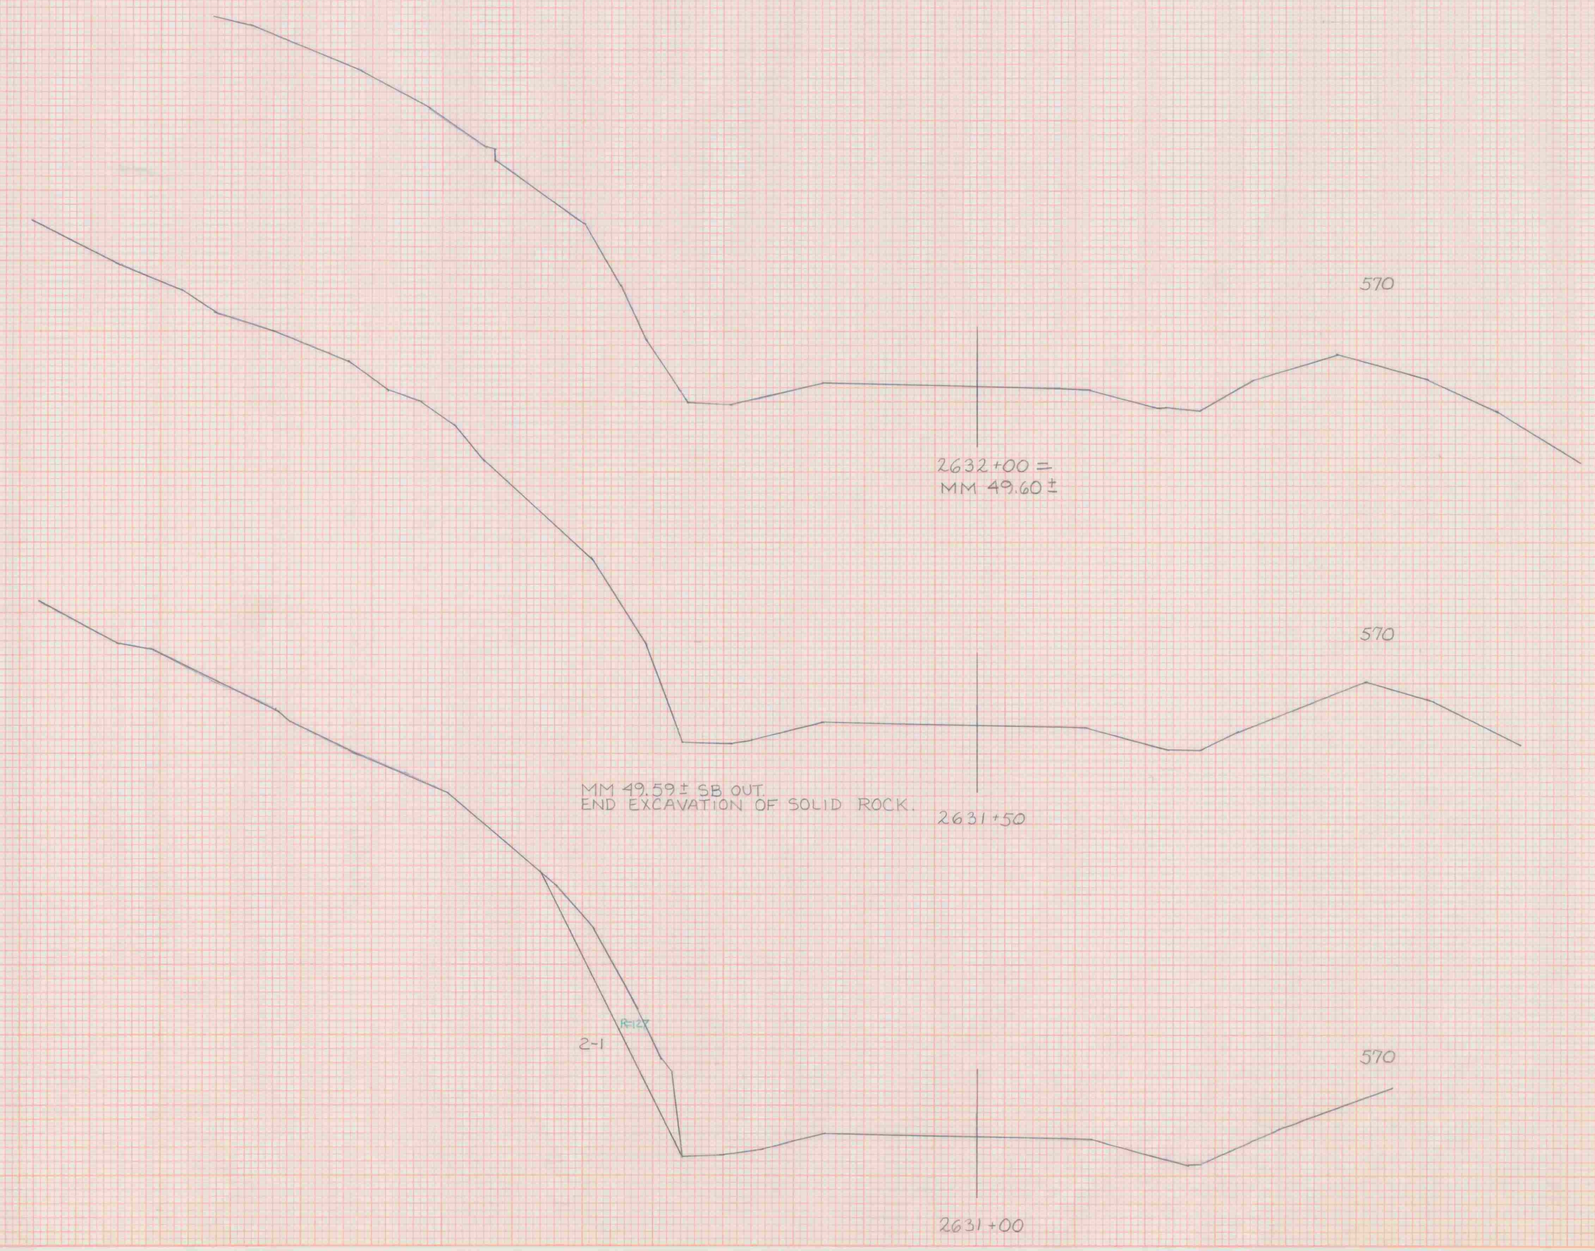

MM. 49.51	MM. 49.59
STA. 2631+0	STA. 2632+0

TOWN SPRINGFIELD-HARTFORD
PROJECT IR NO 091-1(20)
SHEET 85 OF 133 SHEETS
HORIZ. AND VERT. SCALE:
1" = 10'
DATE: JAN. '90

FINAL SURVEY — NOTE BOOK NO. — PLOTTED BY — TEMPLATE — AREAS — AREAS CHECKED — BY — DATE

ORIGINAL SURVEY — NOTE BOOK NO. — PLOTTED BY — TEMPLATE — AREAS — AREAS CHECKED — BY — DATE

Keuffel & Esser Company PLATE 3, CROSS SECTION 487066 Made in U.S.A.