


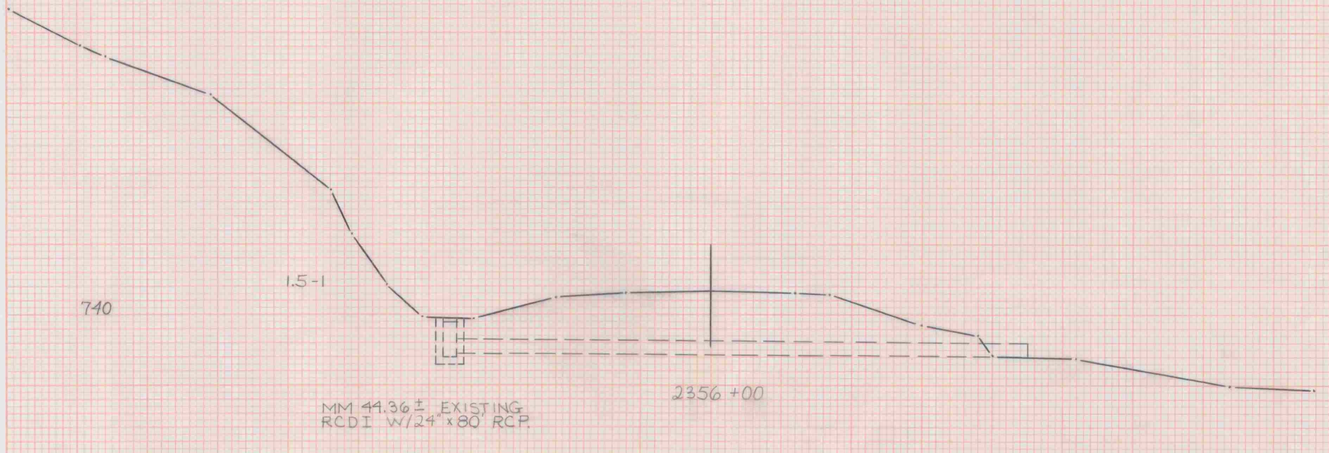

SOUTHBOUND

MM	44.34	MM	44.45
STA	2356+0	STA	2357+0

TOWN SPRINGFIELD-HARTFORD
PROJECT IR 091-1(20)
HORIZ. & VERT. SCALES
1"=10'
DATE : JAN. 190
SHEET 90 OF 133 SHEETS

Keuffel & Esser Company PLATE 3. CROSS SECTION 467056 Made in U.S.A.