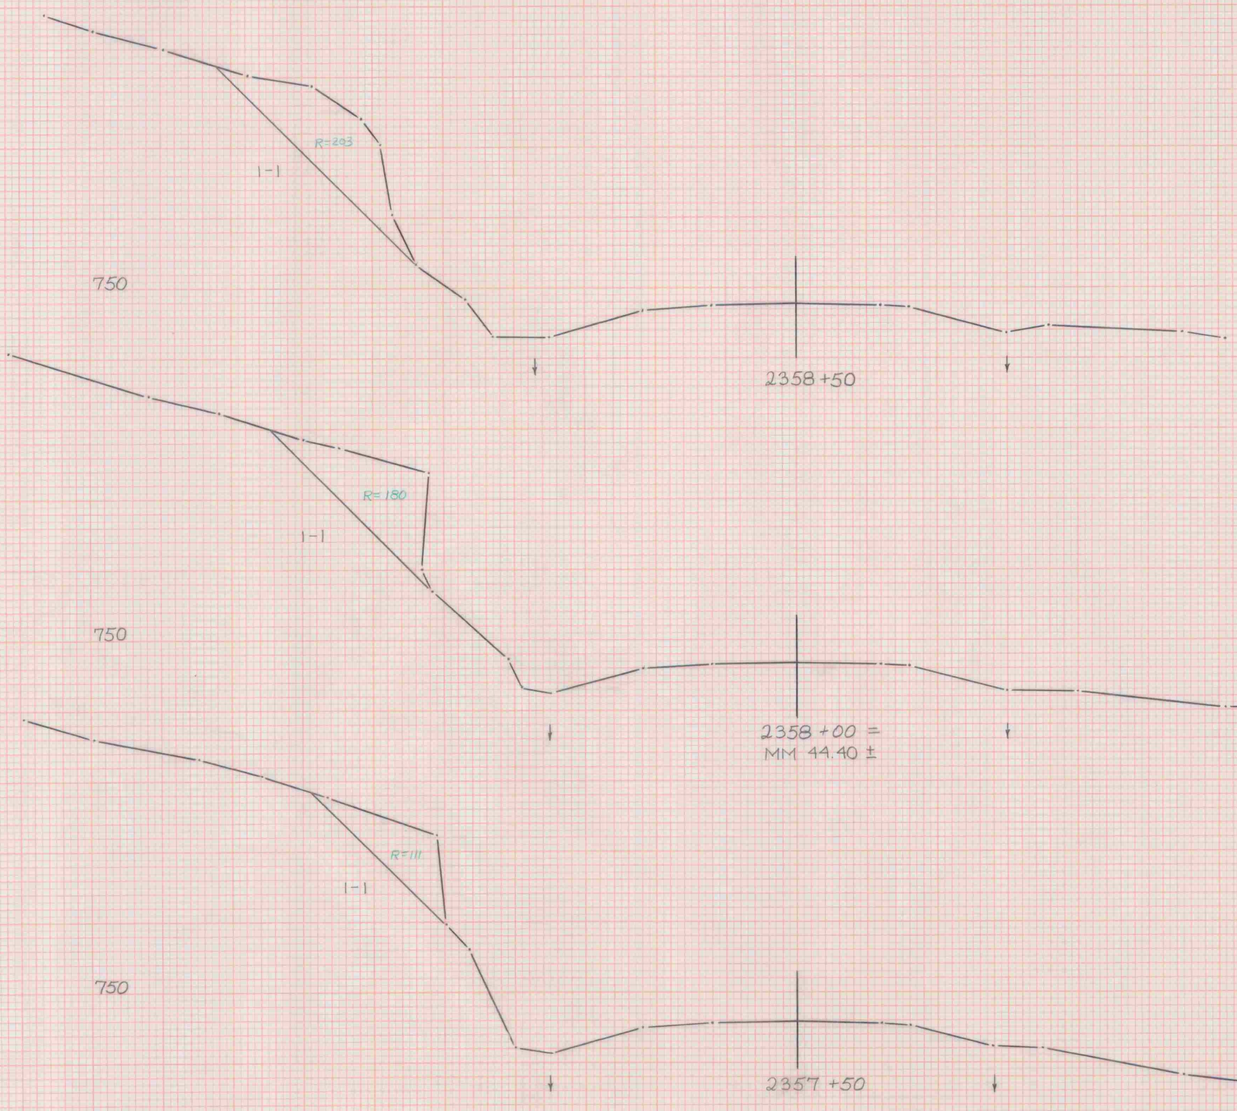

SOUTHBOUND

MM 44.34	MM 44.45
STA 2357+50	STA 2358+50

TOWN SPRINGFIELD-HARTFORD
PROJECT IR 091-1(20)
HORIZ. & VERT. SCALES
1"=10'
DATE : JAN '90
SHEET 91 OF 133 SHEETS

FINAL SURVEY
NOTE BOOK
NO.
SURVEYED
PLOTTED
TEMPLATE
AREAS
AREAS CHECKED
BY
DATE

ORIGINAL CONTACT
NOTE BOOK
NO.
SURVEYED
PLOTTED
TEMPLATE
AREAS
AREAS CHECKED
BY
DATE

Keuffel & Esser Company PLATE 3, CROSS SECTION 4B7056 Made in U.S.A.