



730


2392+50

SB 2392+40.3
EXIST. 24" x 196' ACCGMP
14 ga.

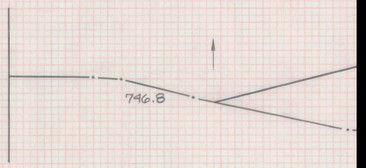



730

2392+00 =
MM 45.06 ± SB

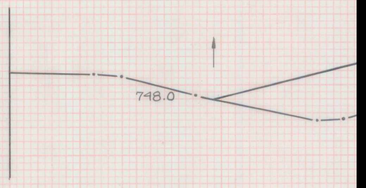


730

2391+50

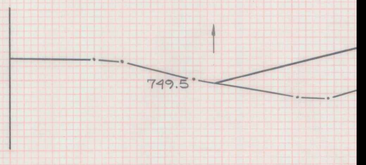


2391+00

730