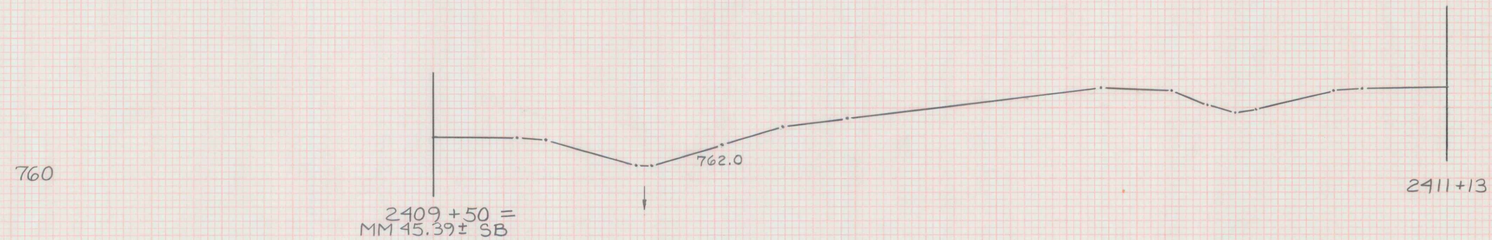

SB 2408+88 RT. ~ NB 2410+50 LT.
EXISTING BITUMINOUS CONCRETE DITCH

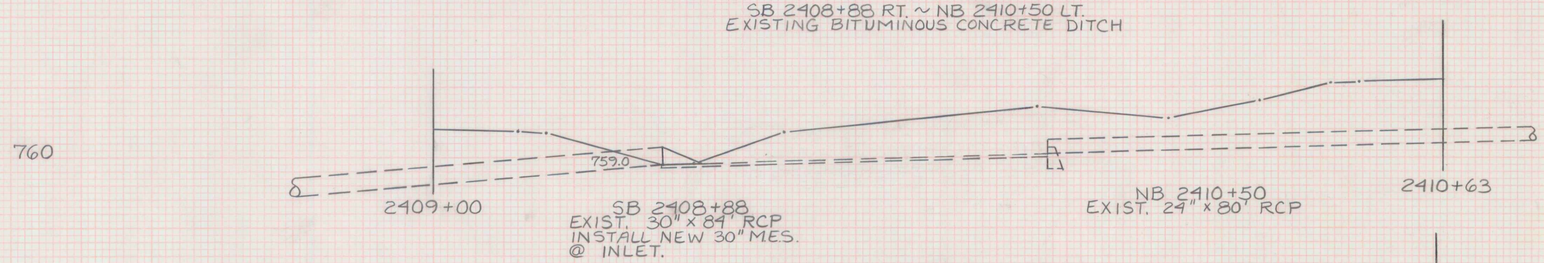

STA. 2408+85 SB (MM 45.38± SB)
END SLOPE FLATTENING IN MEDIAN

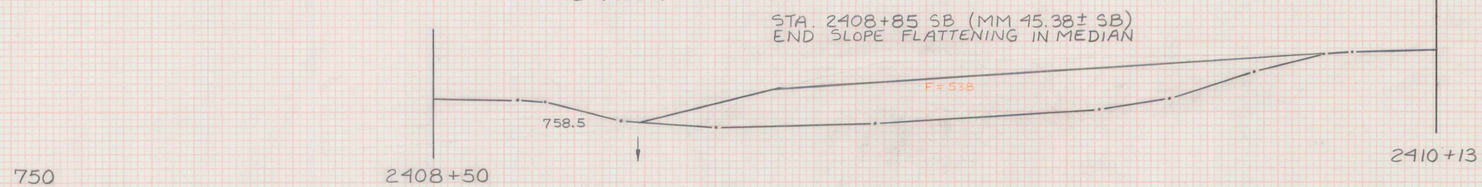

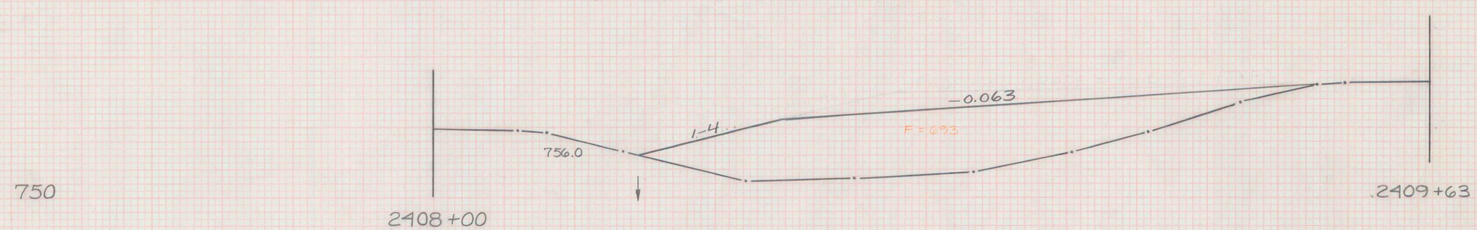

ROCK DISPOSAL AREA

MM 45.00	MM 45.38
STA 2408+0	STA 2409+50
TOWN SPRINGFIELD-HARTFORD	
PROJECT IR 091-1(20)	
HORIZ. & VERT. SCALES 1"=10'	
DATE : OCT. 4, 1990	
SHEET 102 OF 133 SHEETS	