




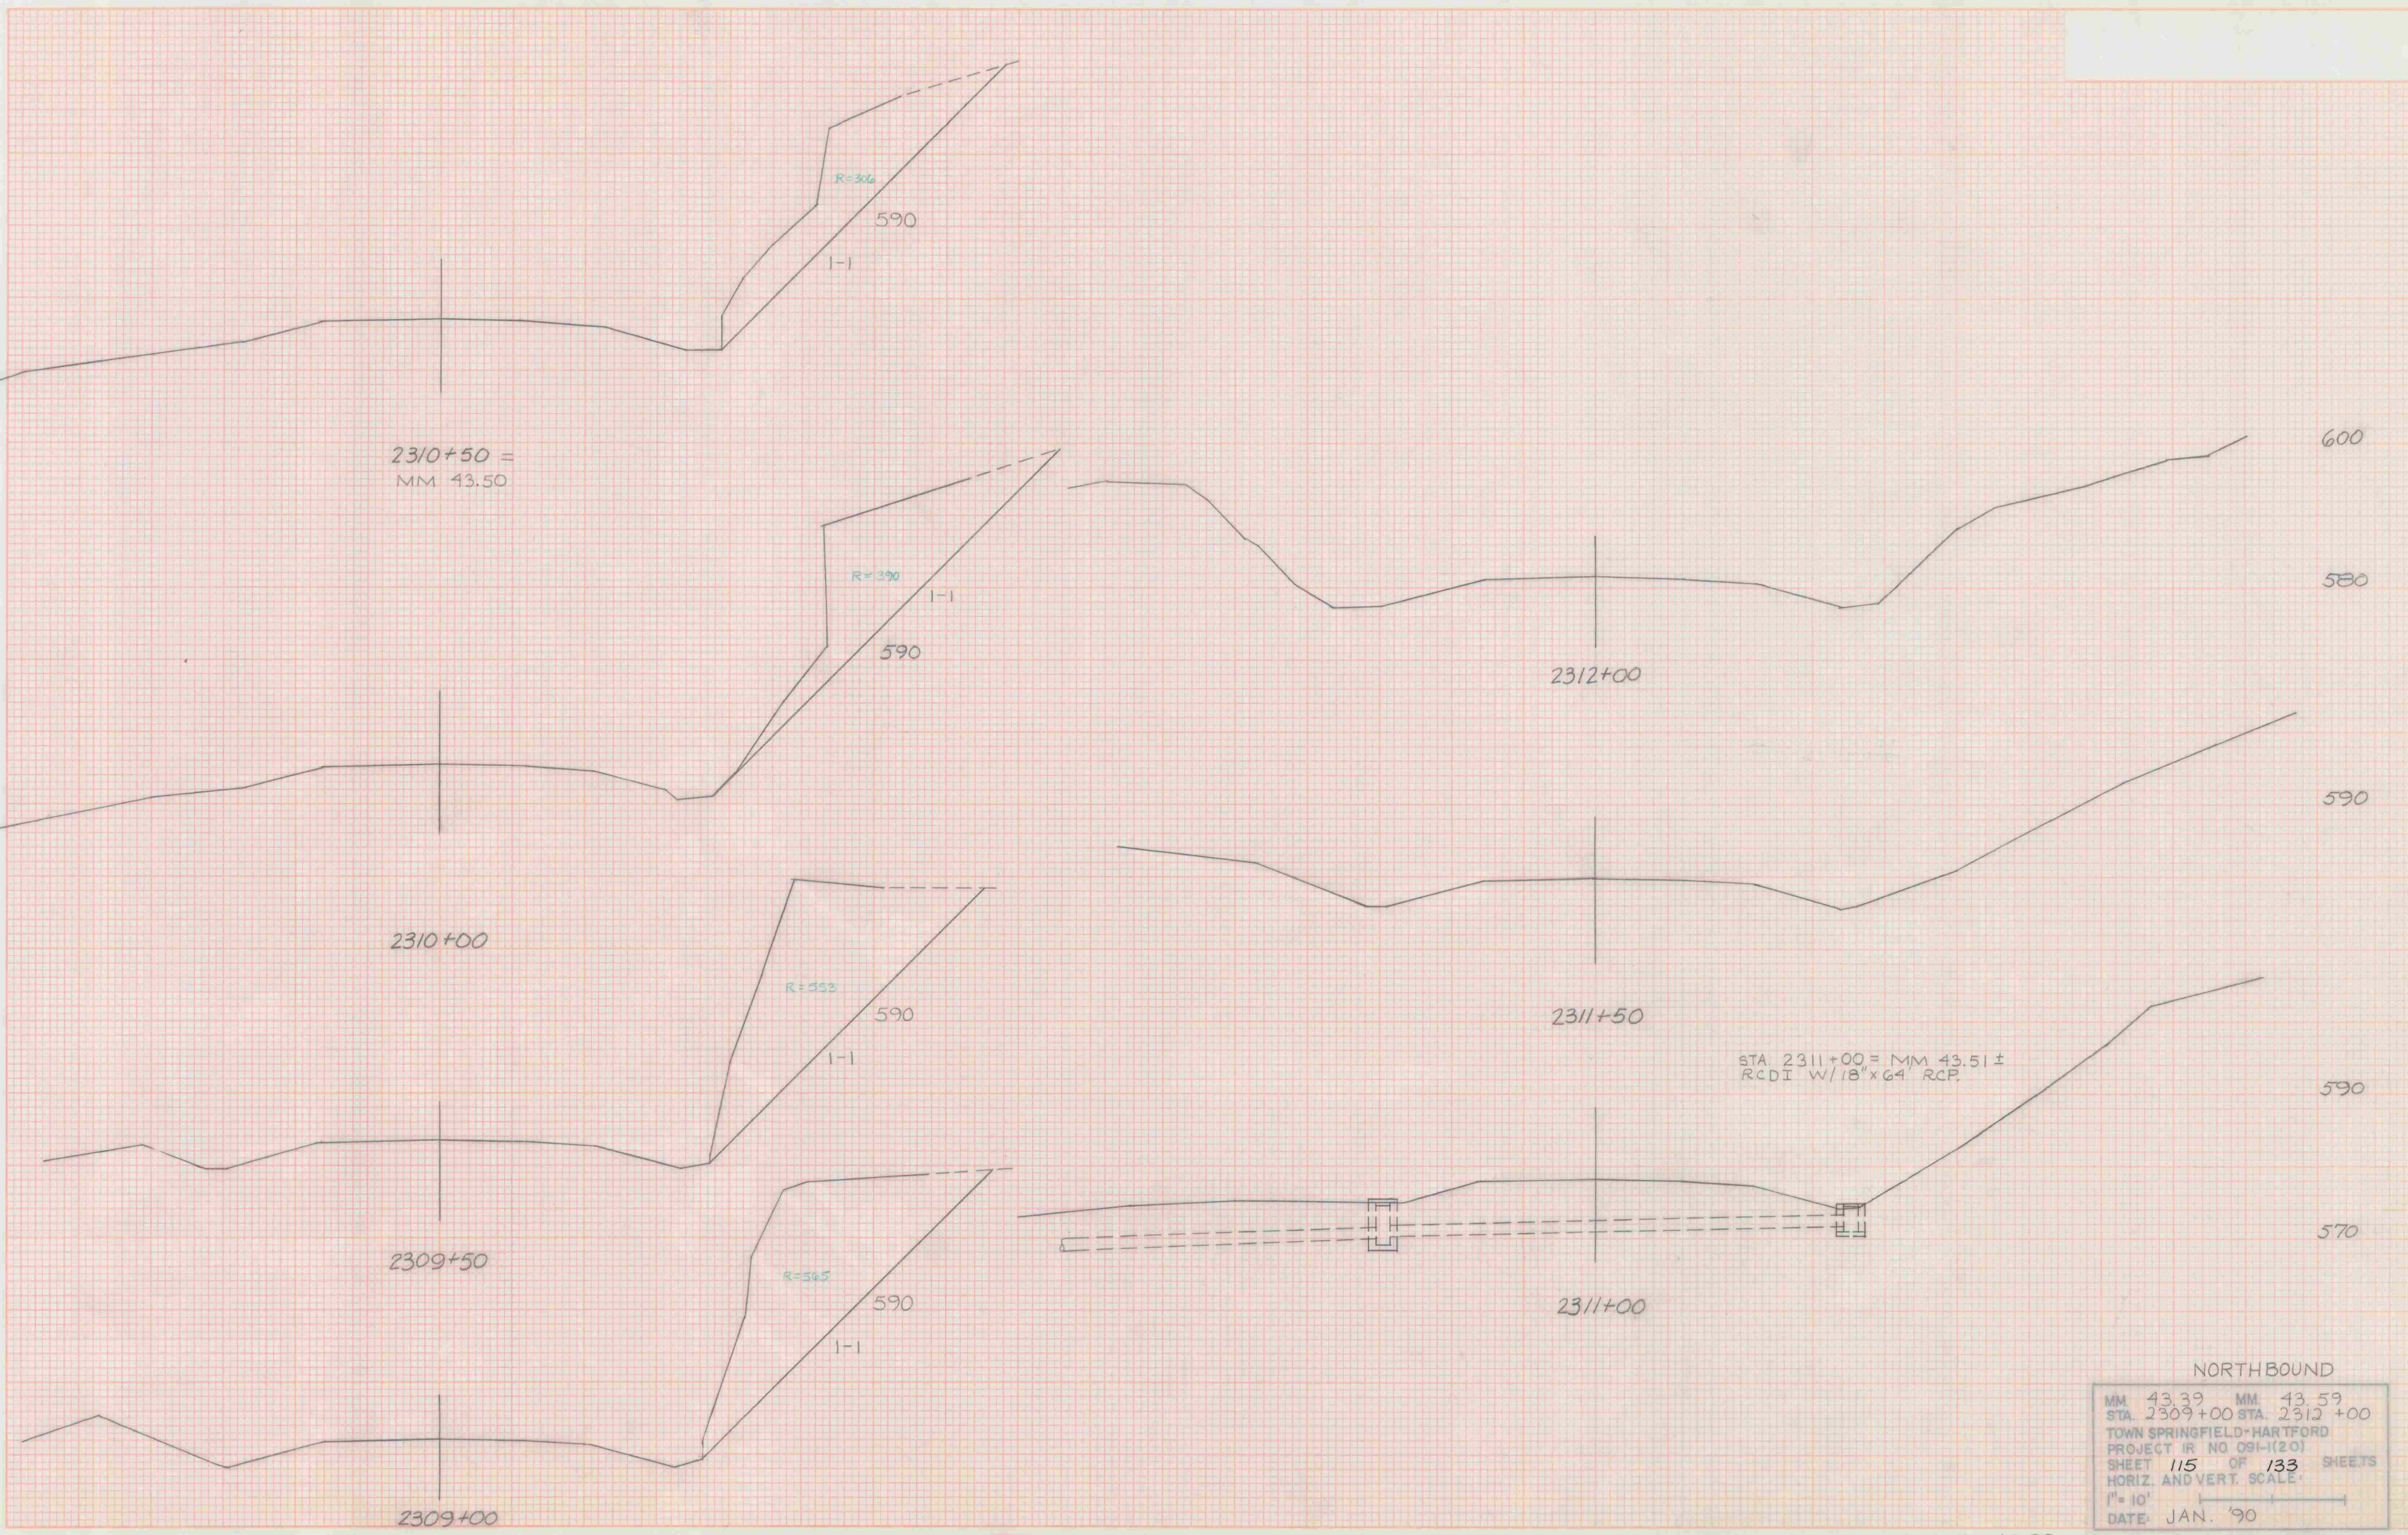

NORTHBOUND  
 MM 43.39    MM 43.59  
 STA. 2309+00    STA. 2312+00  
 TOWN SPRINGFIELD-HARTFORD  
 PROJECT IR NO 091-1(20)  
 SHEET 115 OF 133 SHEETS  
 HORIZ. AND VERT. SCALE:  
 1" = 10'  
 DATE: JAN. '90