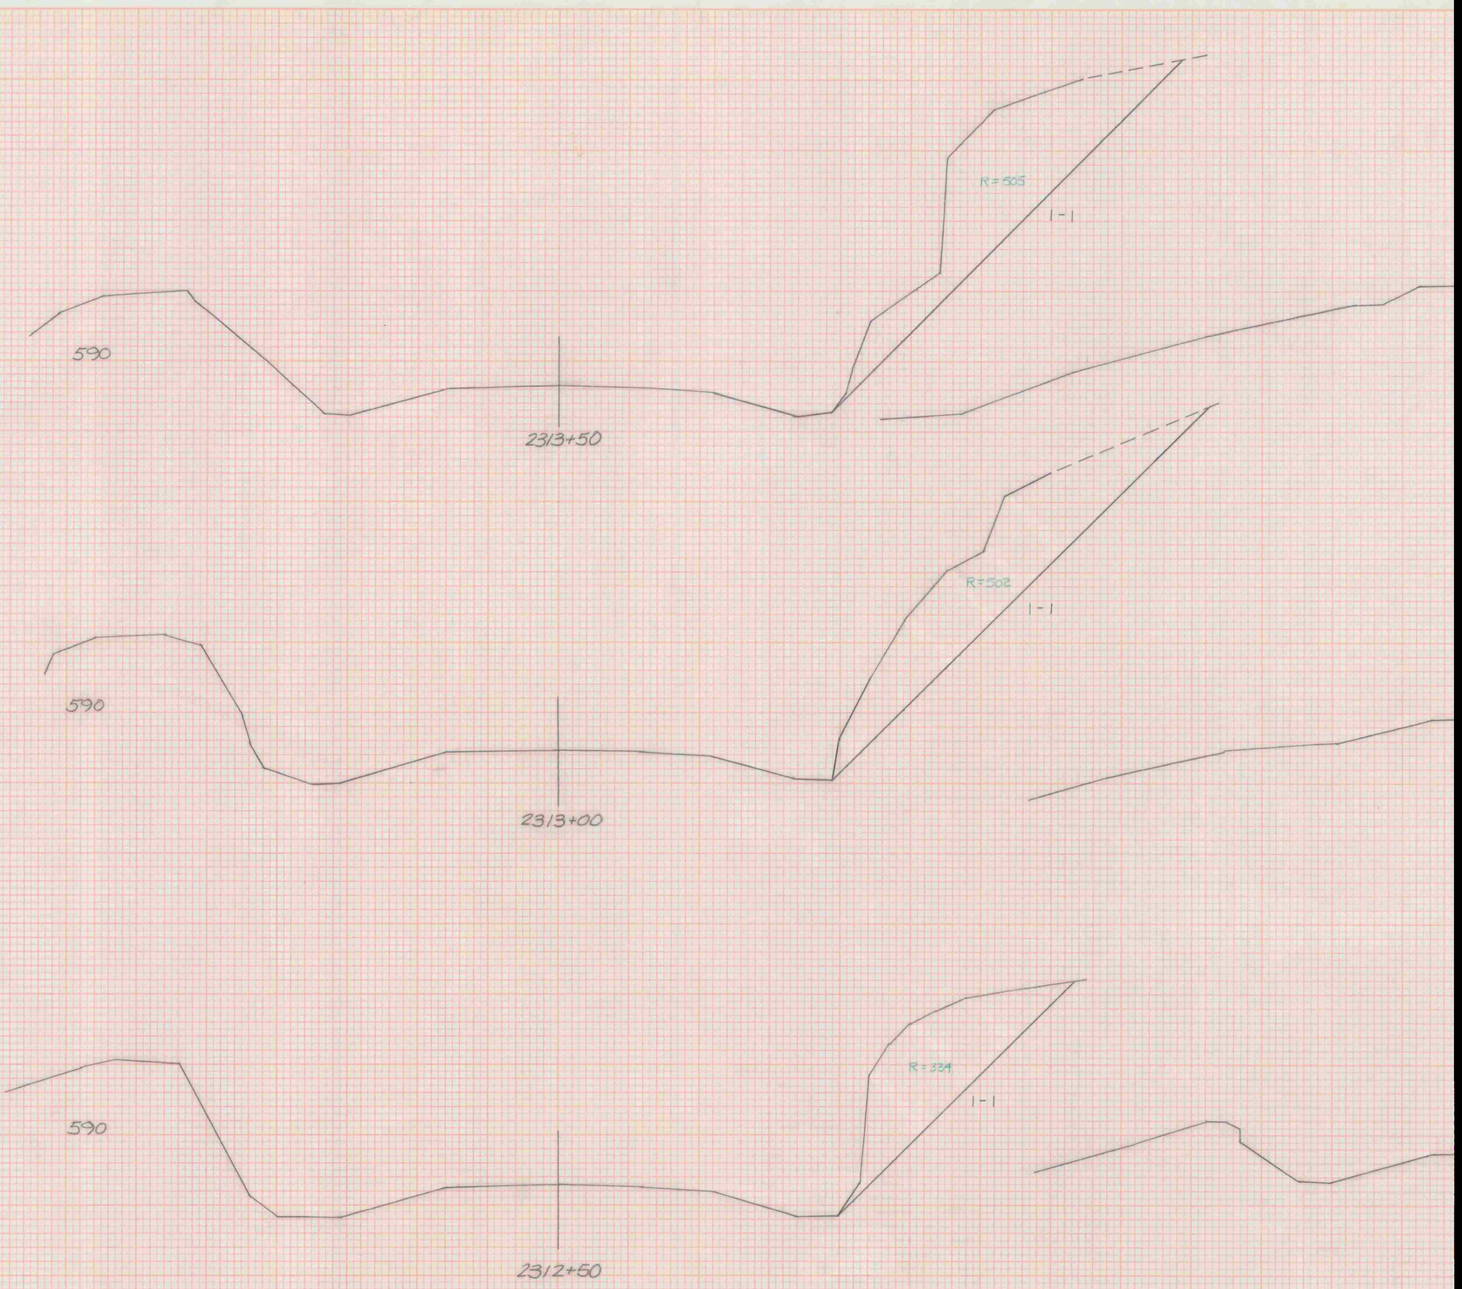


FINAL SURVEY
COMPUTED
CHECKED
AREAS
AREAS CHECKED
NOTE BOOK
NO.
BY
DATE

ORIGINAL SURVEY
SURVEYED
CHECKED
COMPLETE
AREAS
AREAS CHECKED
NOTE BOOK
NO.
BY
DATE