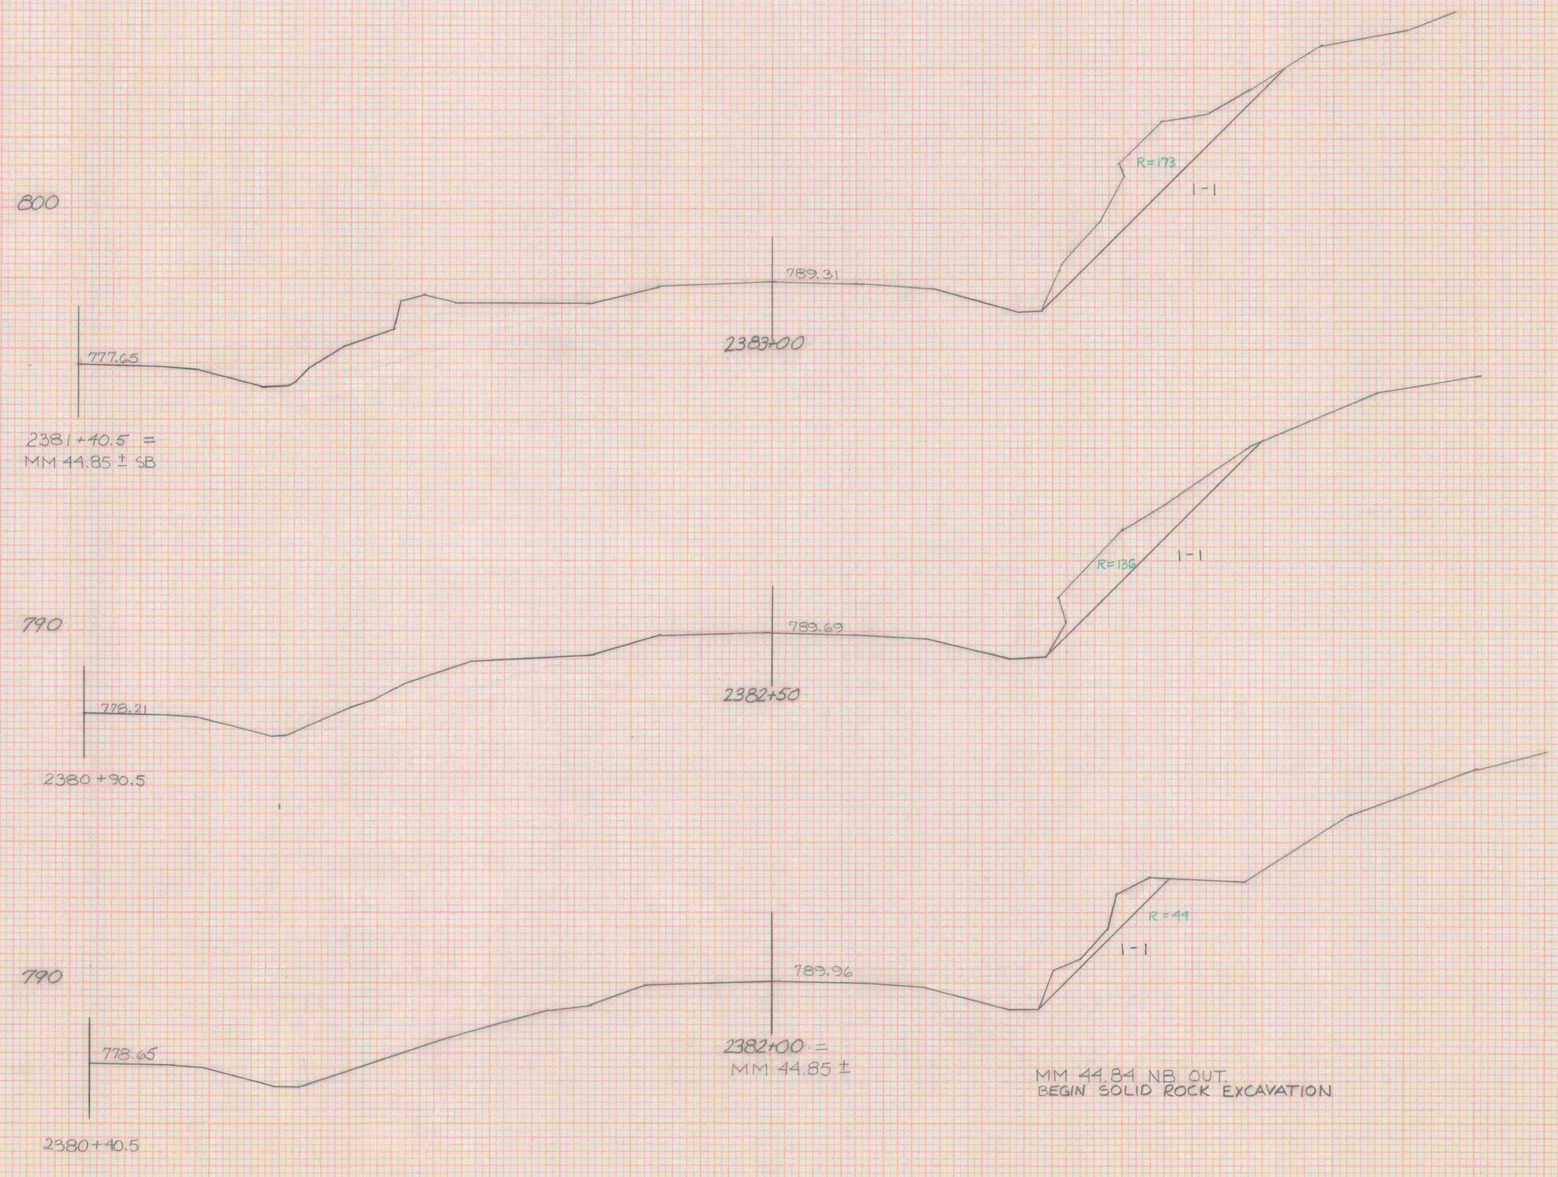

MM. 44.84	MM. 44.95
STA. 2382+0	STA. 2383+0

TOWN SPRINGFIELD-HARTFORD
PROJECT IR NO 091-1(20)
SHEET 118 OF 133 SHEETS
HORIZ. AND VERT. SCALE:
1" = 10'
DATE: JAN. '90

FINAL SURVEY — SURVEYED, PLOTTED, DRAWN, AREAS, AREAS CHECKED, NOTE BOOK, NO., BY, DATE

ORIGINAL SURVEY — SURVEYED, PLOTTED, DRAWN, AREAS, AREAS CHECKED, NOTE BOOK, NO., BY, DATE