FINAL SURVEY
SURVEYED
PLOTTED
NOTE BOOK
AREAS
NO.
AREAS CHECKED
BY
DATE

810

810

810

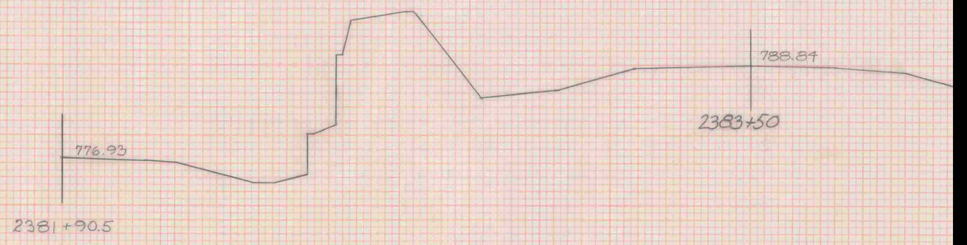

ORIGINAL SURVEY
SURVEYED
PLOTTED
NOTE BOOK
AREAS
NO.
AREAS CHECKED
BY
DATE

KEUFFEL & ESSER