


FINAL SURVEY NOTE BOOK No. \_\_\_\_\_  
 DATE \_\_\_\_\_ BY \_\_\_\_\_  
 SURVEYED BY \_\_\_\_\_  
 DRAWN BY \_\_\_\_\_  
 CHECKED BY \_\_\_\_\_  
 AREA \_\_\_\_\_  
 SCALE \_\_\_\_\_

ORIGINAL SURVEY NOTE BOOK No. \_\_\_\_\_  
 DATE \_\_\_\_\_ BY \_\_\_\_\_  
 SURVEYED BY \_\_\_\_\_  
 DRAWN BY \_\_\_\_\_  
 CHECKED BY \_\_\_\_\_  
 AREA \_\_\_\_\_  
 SCALE \_\_\_\_\_

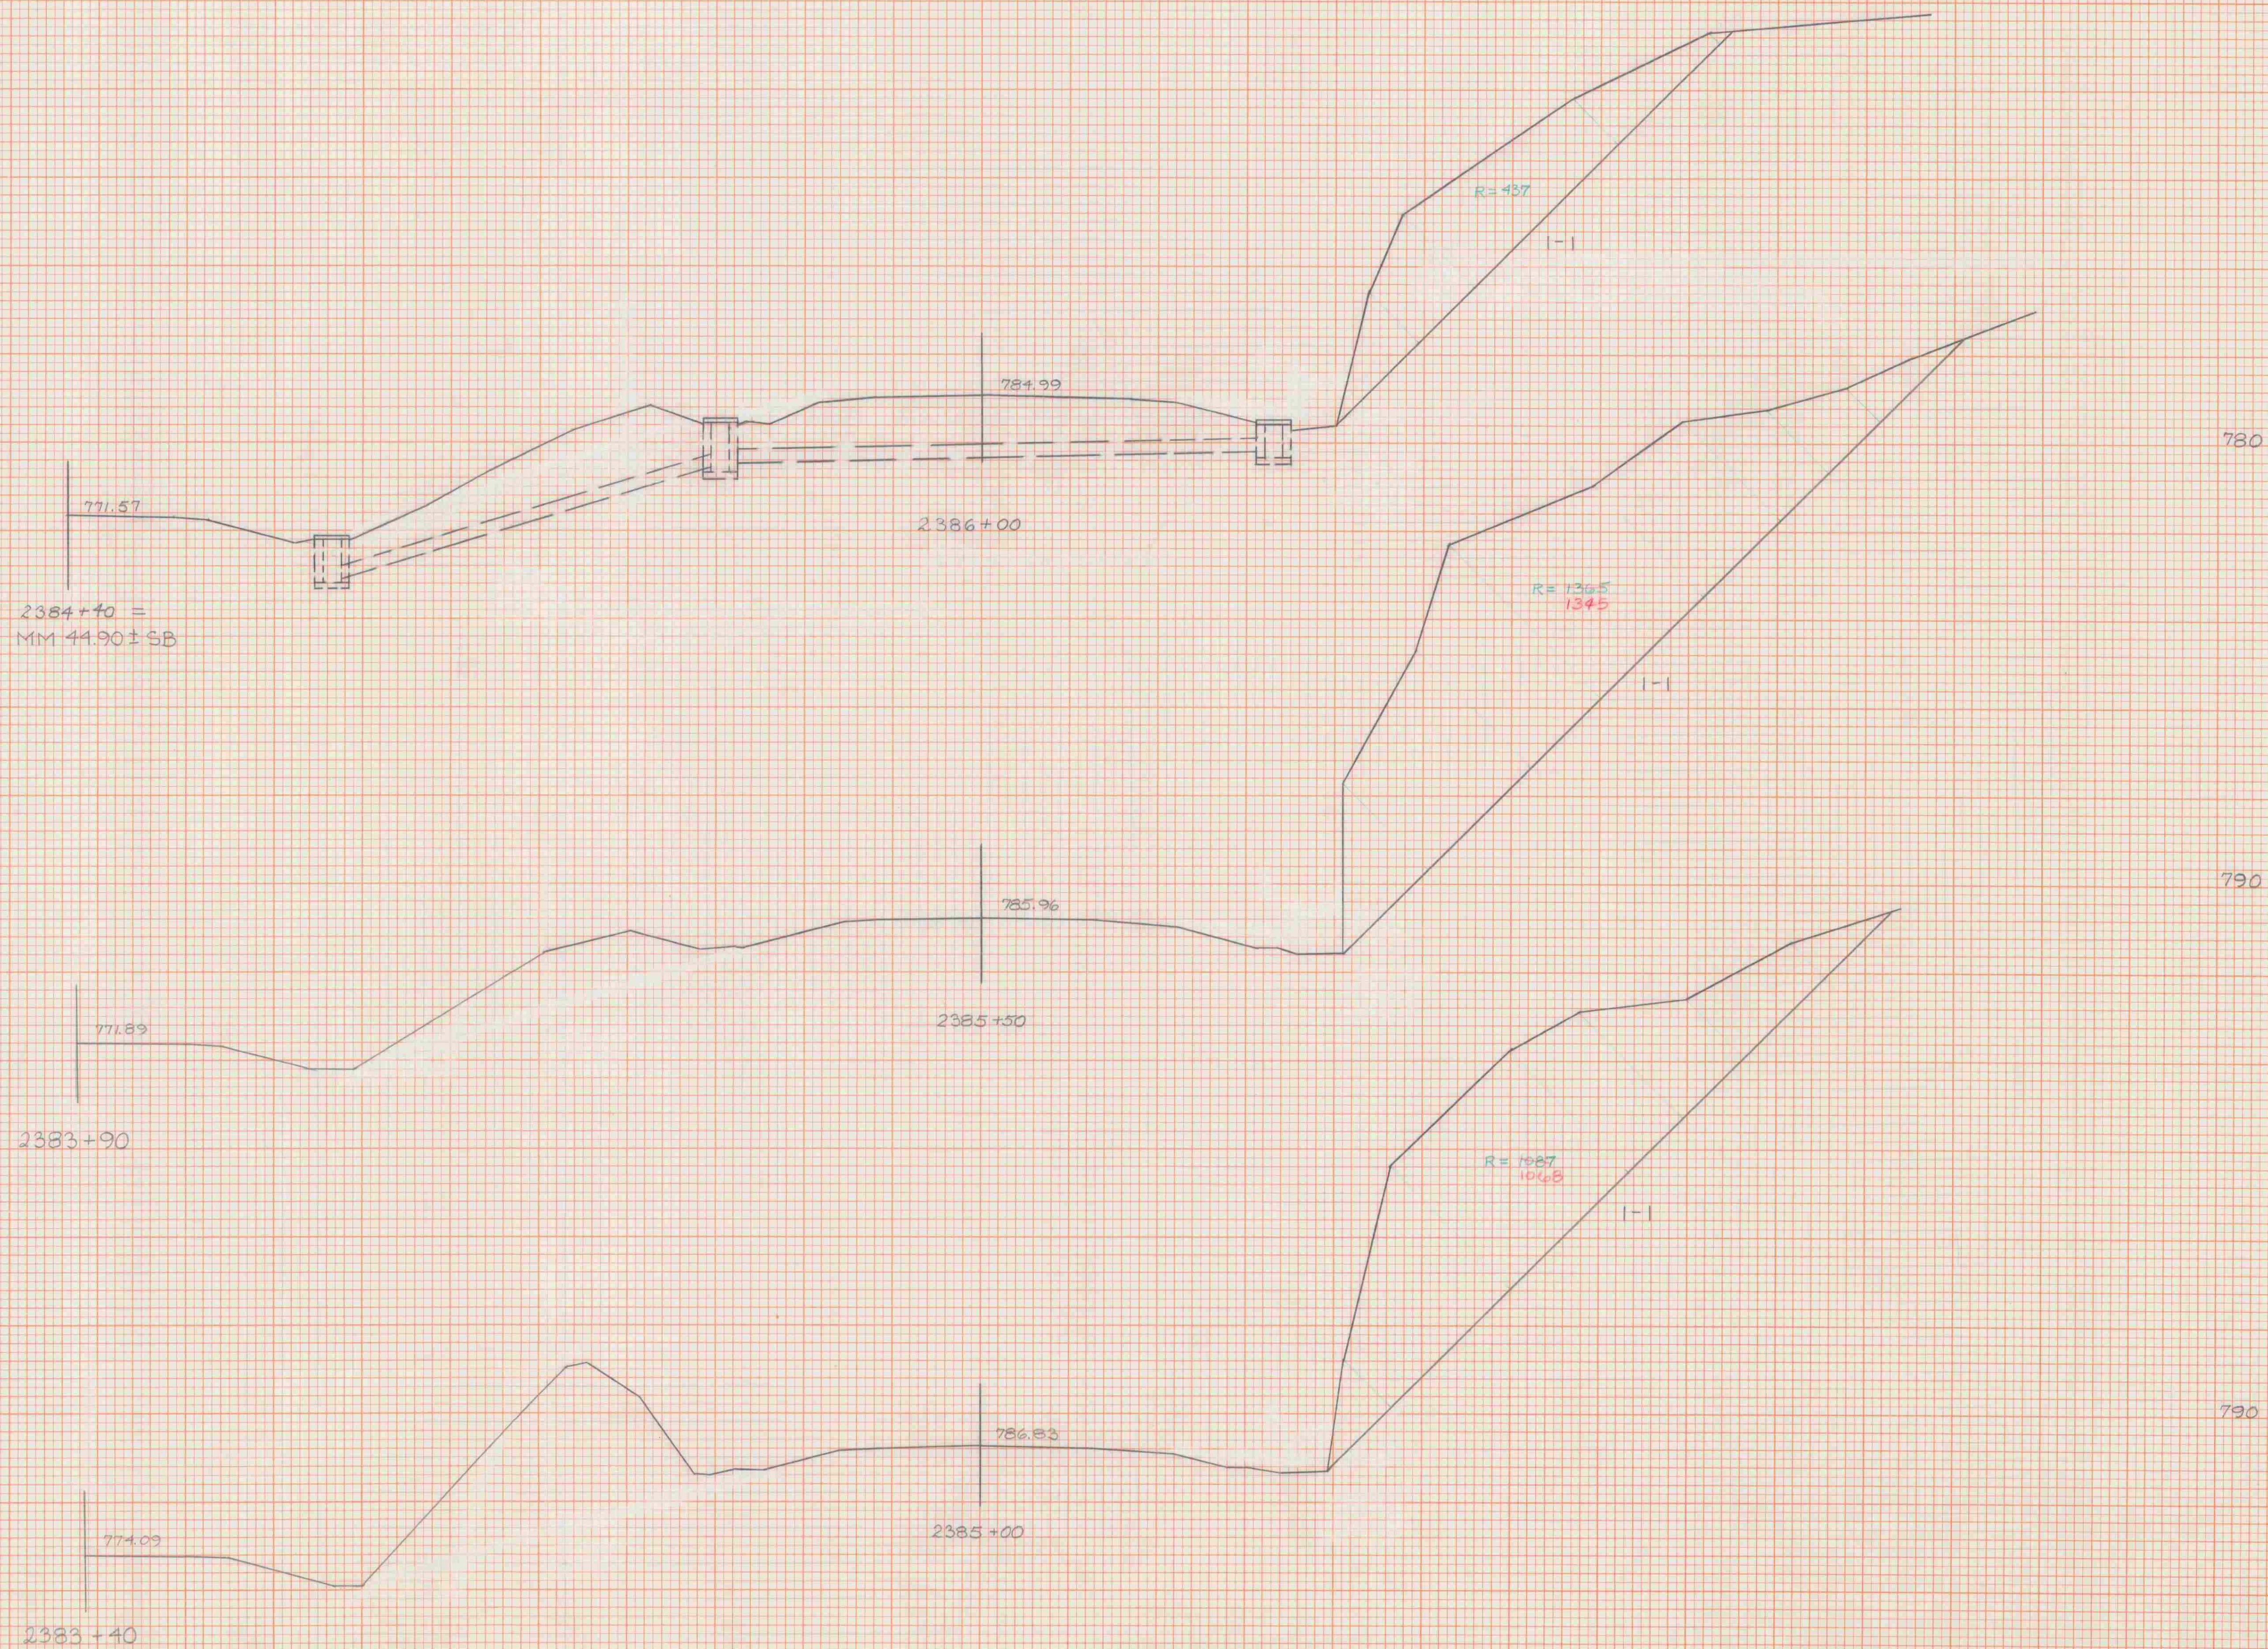

MM 44.84 MM 44.95  
 STA 2385+0 STA 2386+0  
 TOWN SPRINGFIELD-HARTFORD  
 PROJECT IF 091-1(20)  
 HORIZ. & VERT. SCALES  
 1"=30' |-----|  
 DATE: JAN. '90  
 SHEET 120 OF 133 SHEETS