CONSTRUCT NEW SIDEWALK RAMPS AS PER STANDARD C-3.

TO BE PAID UNDER:
SOLID ROCK EXCAVATION, 203.16
PORTLAND CEMENT CONCRETE SIDEWALK - 5'', 618.10
REMOVING AND RESETTING CURB, 616.40

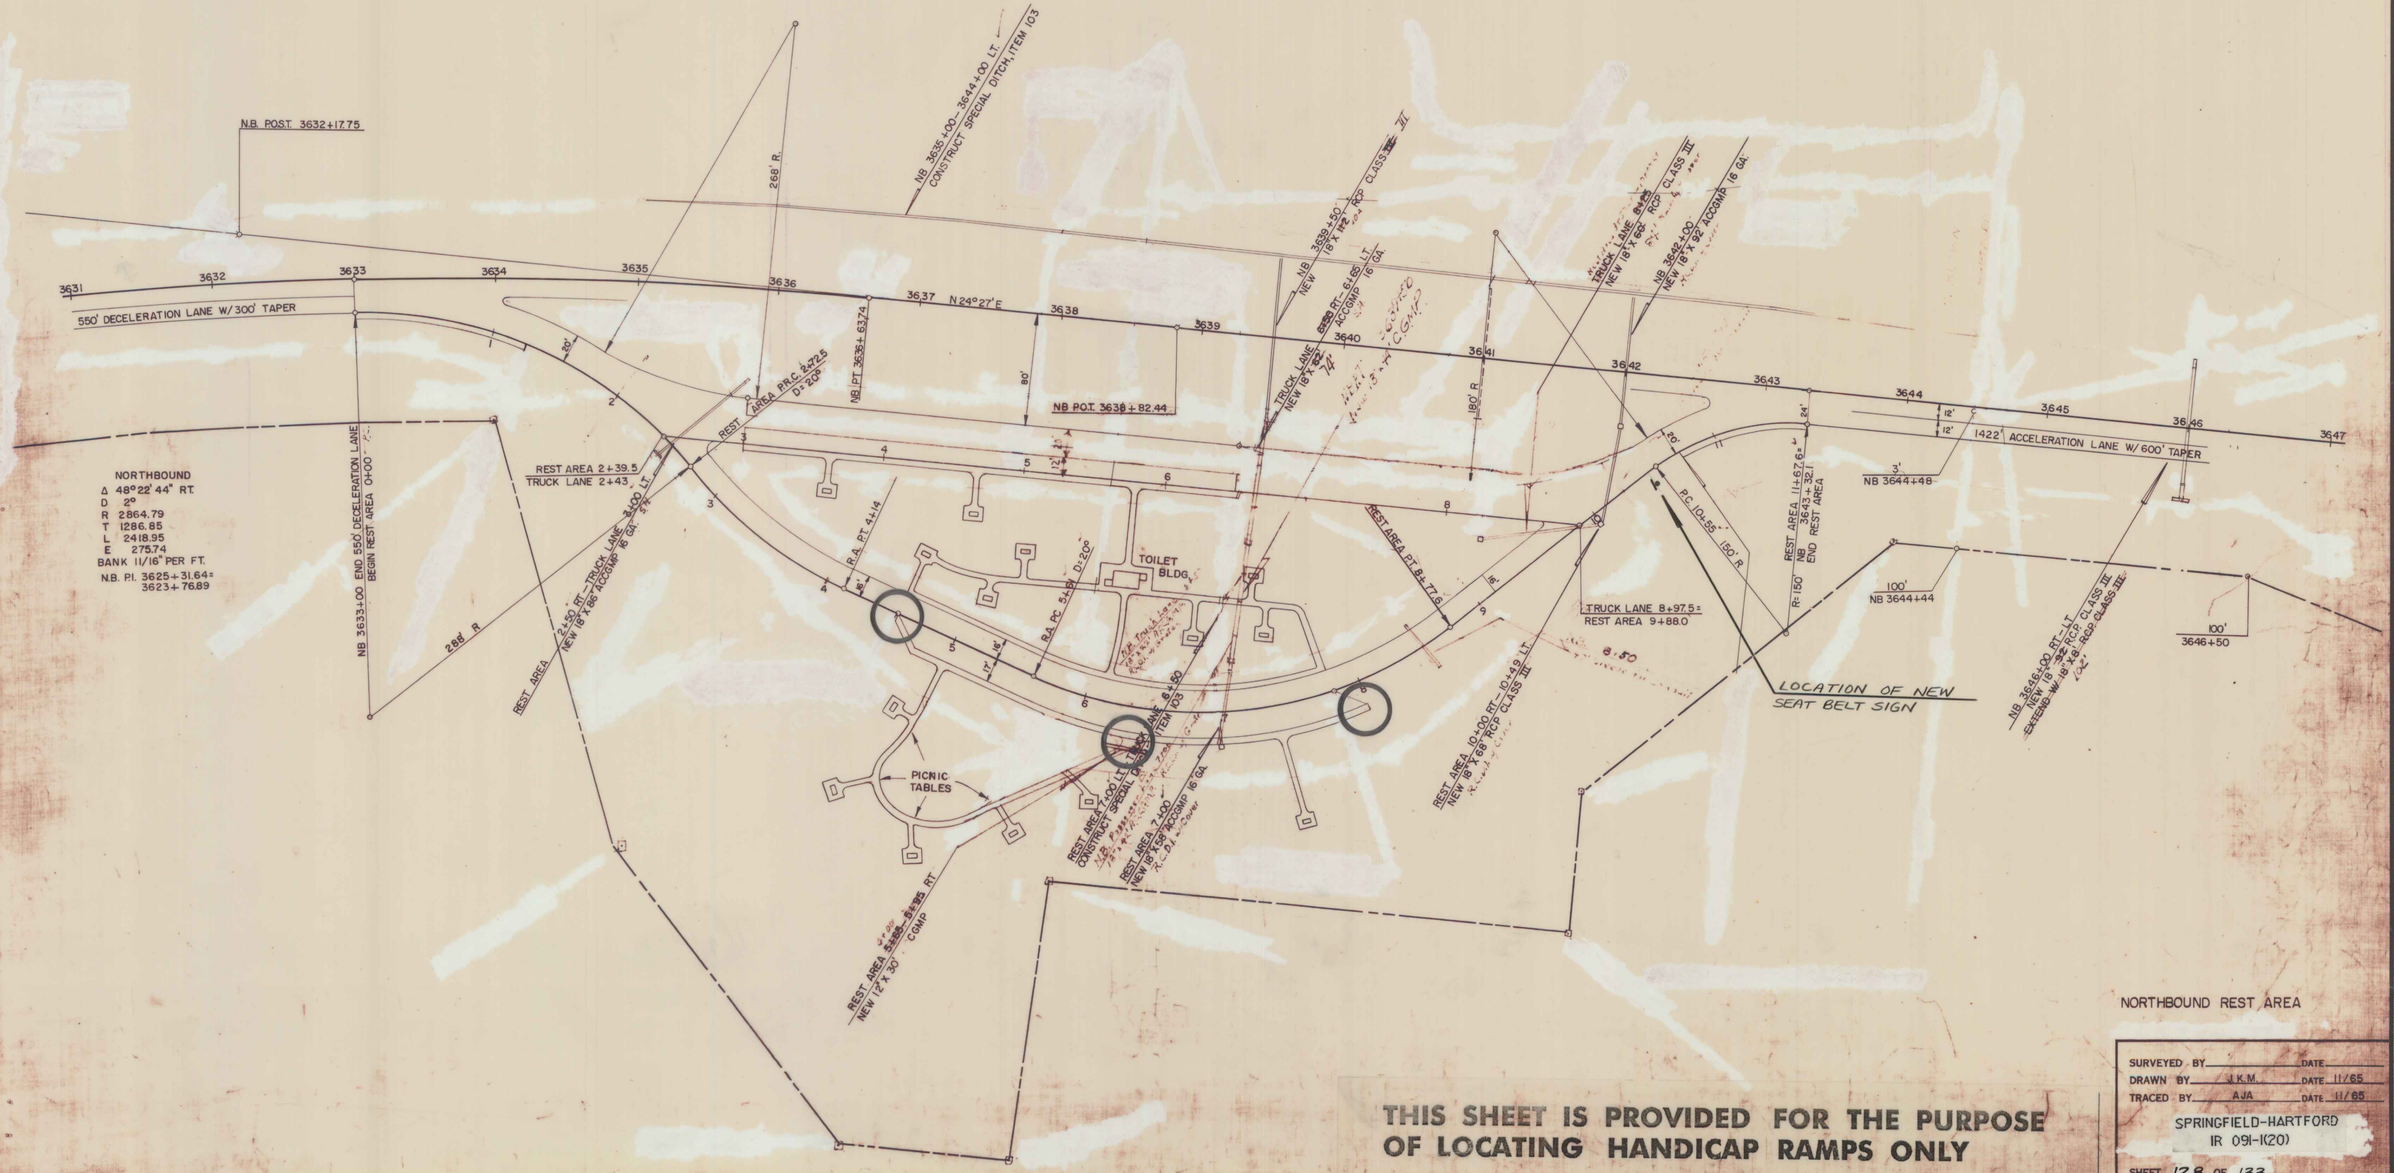

NORTHBOUND REST AREA

SURVEYED BY _____ DATE _____
DRAWN BY J.K.M. DATE 11/65
TRACED BY AJA DATE 11/65

SPRINGFIELD-HARTFORD
IR 091-1(20)

SHEET 128 OF 133

THIS SHEET IS PROVIDED FOR THE PURPOSE OF LOCATING HANDICAP RAMPS ONLY

S.L.M. 264