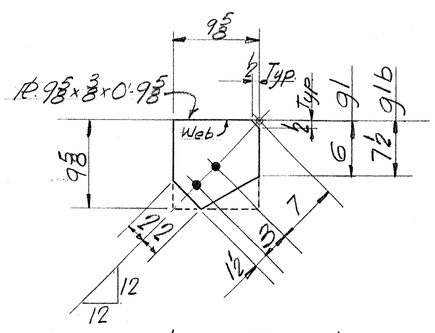

g1-216-Req'd.
g1b-4-Req'd.

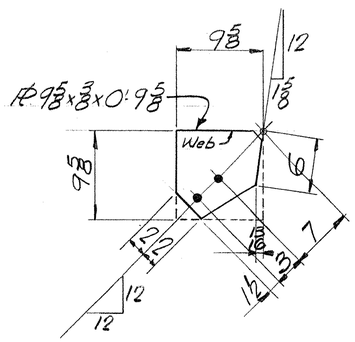

g1a-24-Req'd.

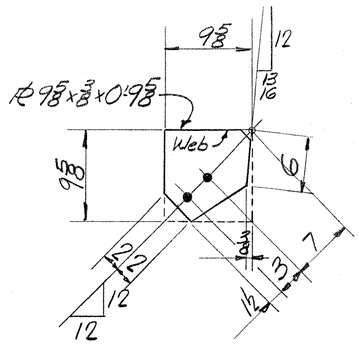

g1c-52-Req'd.

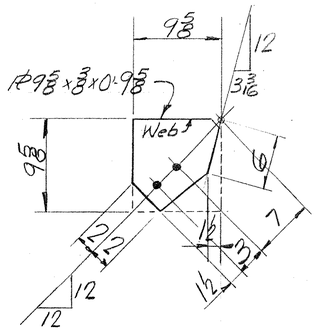

g1d-8-Req'd.

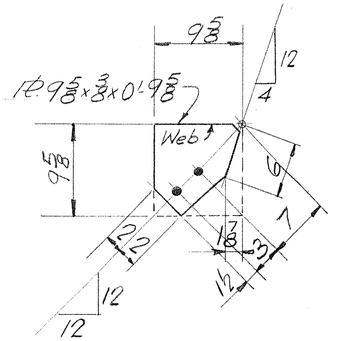

g1e-12-Req'd.

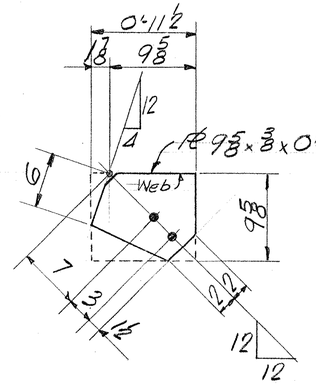

g1f-4-Req'd.

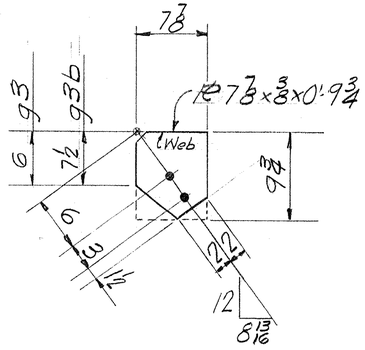

g3-44-Req'd
g3b-4-Req'd

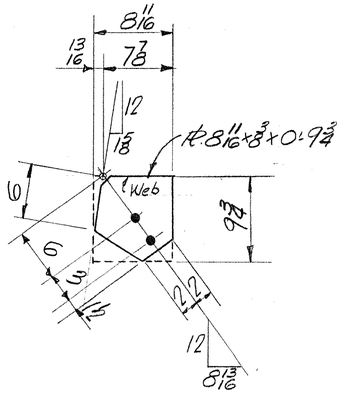

g3a-24-Req'd.

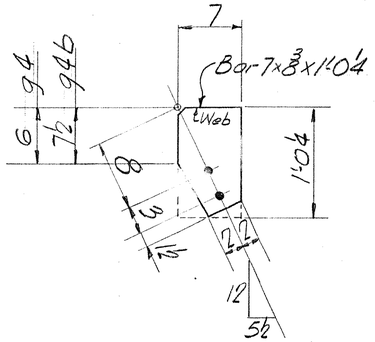

g4-8-Req'd
g4b-8-Req'd

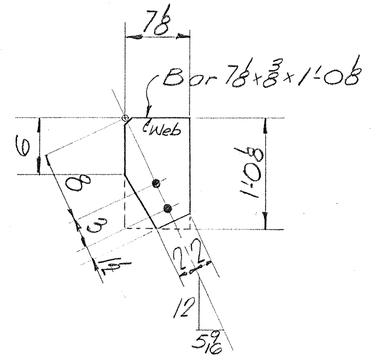

g5-24-Req'd

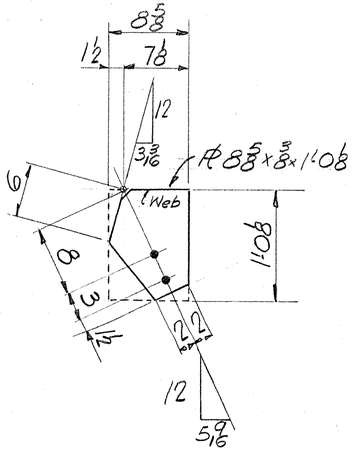

g5d-8-Req'd.

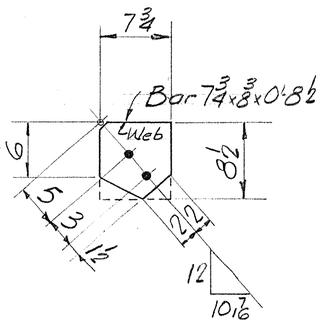

g6-92-Req'd.

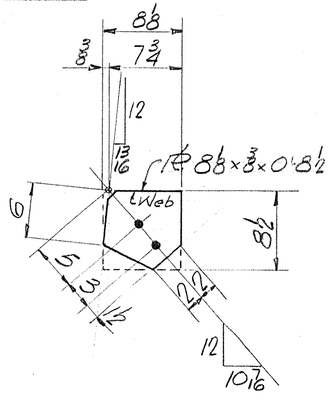

g6c-52-Req'd.

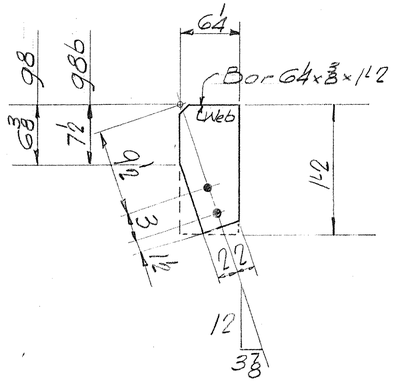

g8-8-Req'd.
g8b-8-Req'd.

15/16" ⌀ Holes

Quantities shown are for One Bridge

IR 089-1(13)
This sheet for information only
BR 11 N & S
SHEET 95 OF 101

PROJ. No. I-89-1(6)

NB & SB BRIDGES

GUSSET DETS. LATERAL BRACING

Bancroft & Martin Inc.
South Portland 7, Maine

I-89 BRIDGE OVER WHITE RIVER
HARTFORD, VERMONT

CUSTOMER CIANCHETTE BROS INC.
DESIGNER VERMONT DEPT. OF HIGHWAYS

ORDER NO. VERBAL
DWG. NO 65-374-521

DRAWN	1-21-66	J.P.F.
REVISION		
REVISION		
REVISION		

APP'D 4-6-66