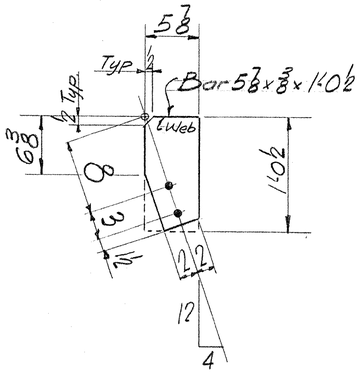

g9-24-Req'd

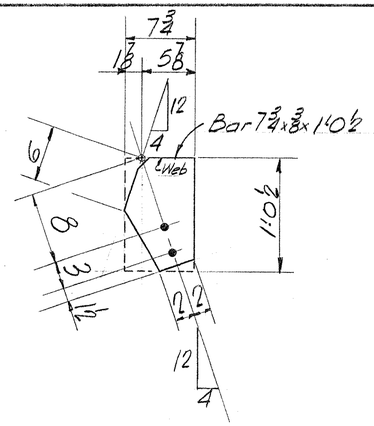

g9e-8-Req'd.

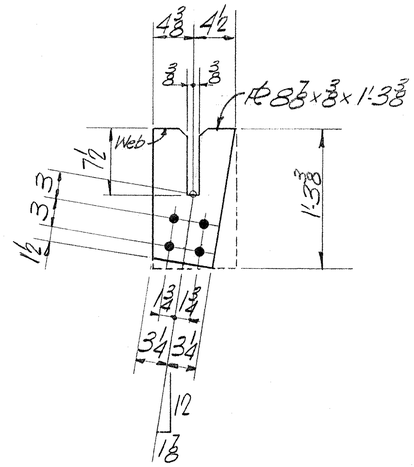

g10b-2-Req'd.

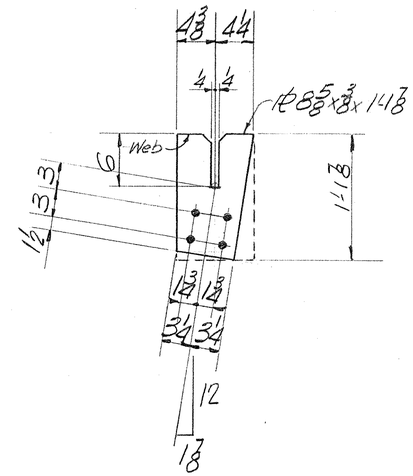

g10-2-Req'd

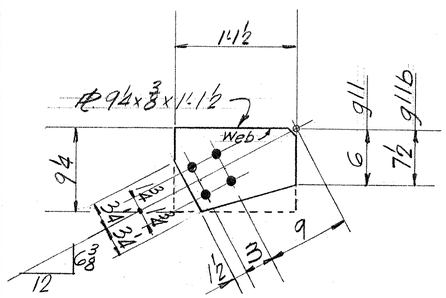

g11-2-Req'd.
g11b-2-Req'd.

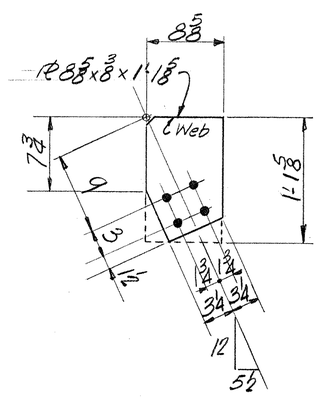

g14-8-Req'd.

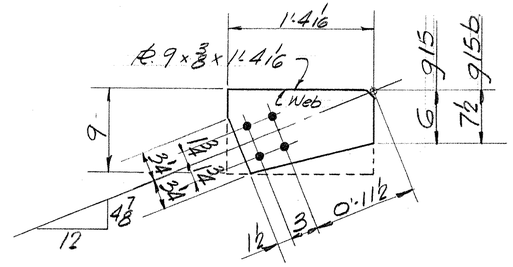

g15-4-Req'd.
g15b-4-Req'd.

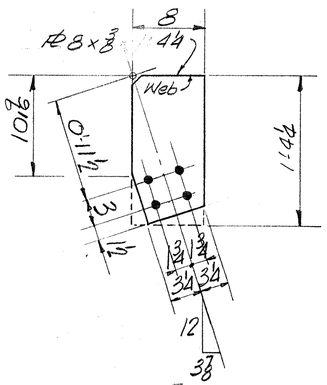

g16-12 Req'd.

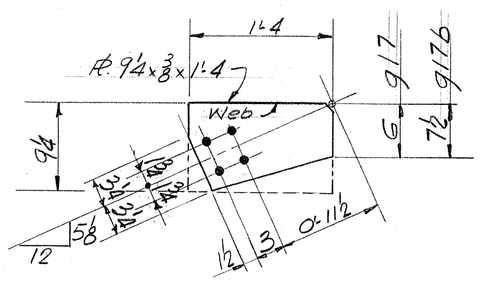

g17-6-Req'd.
g17b-6-Req'd.

15/16" ⌀ Holes

Quantities shown are for One Bridge.

IR 089-1(13)
This sheet for information only
BR 11 N & S

SHEET 96 OF 101

PROJ. No. I-89-1(6)

NB & SB BRIDGES

GUSSET DETS-LATERAL BRACING

Bancroft & Martin Inc.
South Portland 7, Maine

I-89-BRIDGE OVER WHITE RIVER
HARTFORD, VERMONT

APP. 4-6-66

DRAWN	1-25-66	J.P.F.	CUSTOMER CIANCHETTE BROS. INC.
REVISION			DESIGNER VERMONT DEPT. OF HIGHWAYS
REVISION			ORDER NO. VERBAL — DWG. NO. 65-374-S22
REVISION			