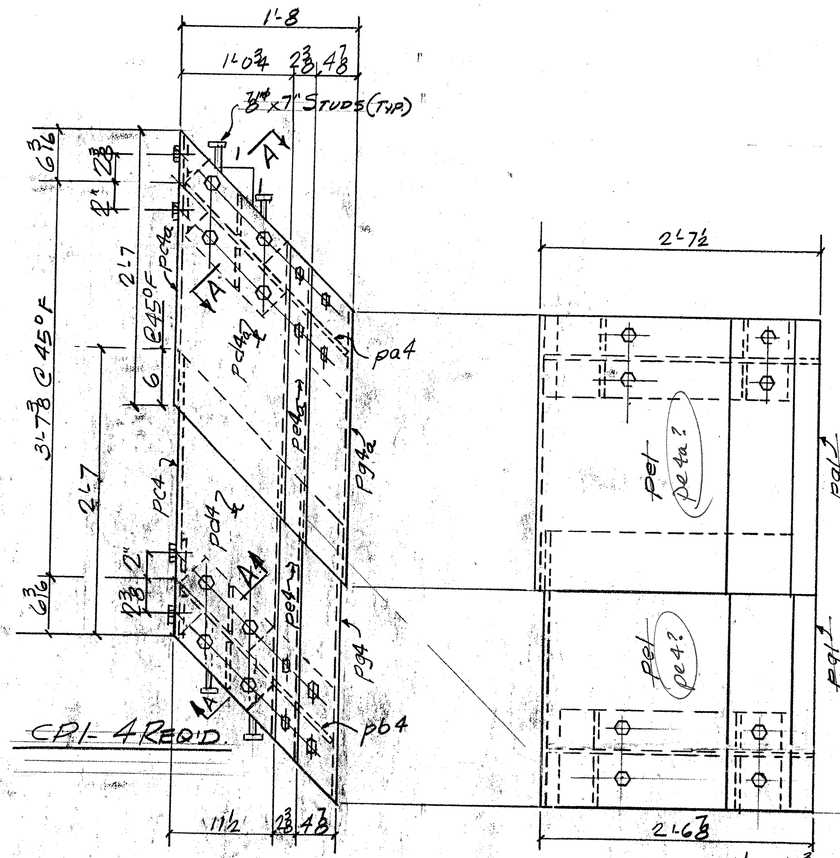

CP1 - 4 REQ'D.

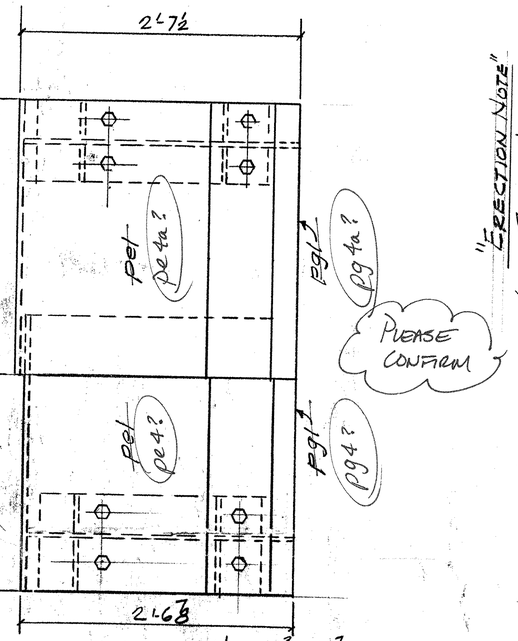

"ERECTION NOTE"
LAP CURB PLATES IN DIRECTION OF TRAFFIC

PLEASE CONFIRM

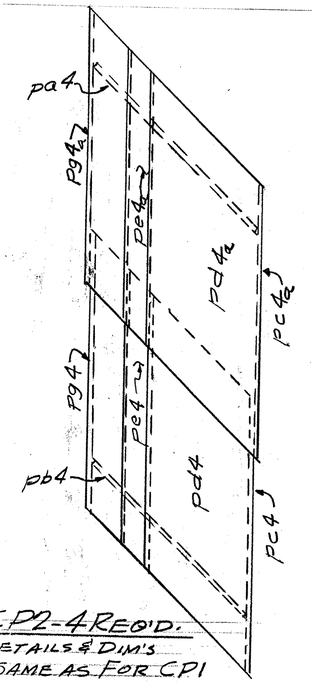

CP2 - 4 REQ'D.
DETAILS & DIM'S SAME AS FOR CP1

ABM INFO PAGE	LINE	NO.	DESCRIPTION	FT	IN	ASSEM. MARK	SHIPPING MARK	REMARKS	WEIGHT
		4	CURB PL ASS'Y	6	4 1/2		CP1		—
		4	DO	6	4 1/2		CP2		—
		8	PL 3/8 x 26 3/4	2	7 1/8	pa4			
		8	PL 3/8 x 25	2	6 1/2	pb4			
		8	PL 3/8 x 30 1/2	2	7	pc4			
		8	PL 3/8 x 31 1/8	2	7	pd4a			
		8	PL 3/8 x 10 3/4	3	5 3/4	pd4			
		8	PL 3/8 x 12	3	7	pd4a			
		8	PL 3/8 x 21	2	9 3/8	pe4			
		8	PL 3/8 x 21 1/8	2	9 3/8	pe4a			
		8	PL 3/8 x 11 1/8	2	11 1/8	pg4		BEND	
		8	PL 3/8 x 12 1/8	2	11 1/8	pg4a		BEND	
		1	BAR 4 x 3/8	260	0	ba4		CUT TO FIT. W/NUT & WASH.	
		192	3/4" ϕ BOLTS		1 3/4	SHOP			
		144	7/8" ϕ STUDS		7	SHOP			

PAY ITEM 516.10

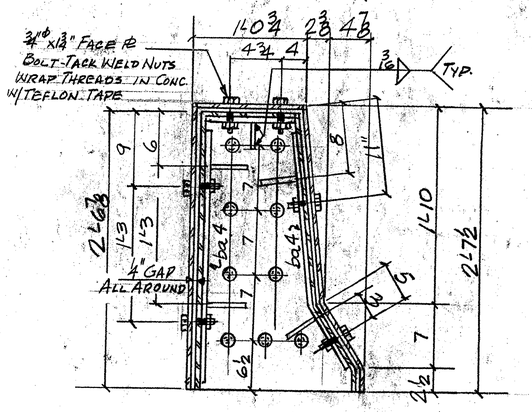

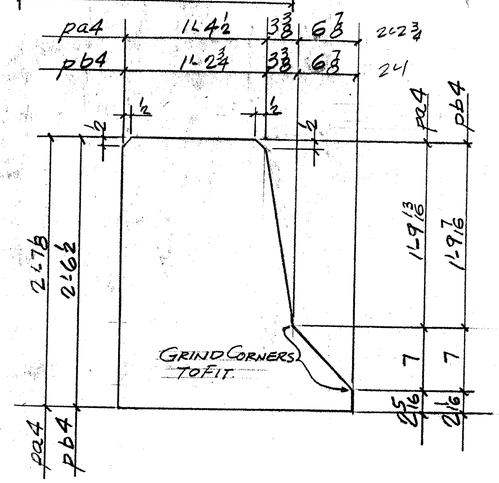

DETAIL @ pa4 & pb4

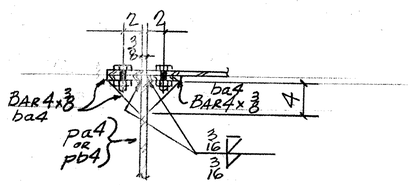

TYP. SECT. A-A

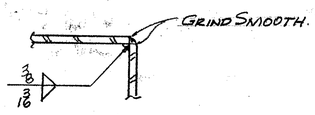

TYP. CORNER JOINT.

SHOP DRAWING REVIEW

☐ REVIEWED AS REQUIRED BY THE CONSTRUCTION CONTRACT DOCUMENTS AND APPROVED, BUT ONLY FOR CONFORMANCE TO THE DESIGN CONCEPT OF THE WORK, AND SUBJECT TO FURTHER LIMITATIONS AND REQUIREMENTS CONTAINED IN THE CONSTRUCTION CONTRACT DOCUMENTS.

☐ REJECTED ☐ REVISE AND RESUBMIT ✓ FURNISH AS CORRECTED

CORRECTIONS OR COMMENTS MADE ON THE SHOP DRAWINGS DURING THIS REVIEW DO NOT RELIEVE CONTRACTOR FROM COMPLIANCE WITH REQUIREMENTS OF THE DRAWINGS AND SPECIFICATIONS. THIS CHECK IS ONLY FOR REVIEW OF GENERAL CONFORMANCE WITH THE DESIGN CONCEPT OF THE PROJECT AND GENERAL COMPLIANCE WITH THE INFORMATION GIVEN IN THE CONTRACT DOCUMENTS. THE CONTRACTOR IS RESPONSIBLE FOR CONFIRMING AND CORRELATING ALL QUANTITIES AND DIMENSIONS; SELECTING FABRICATION PROCESSES AND TECHNIQUES OF CONSTRUCTION; COORDINATING THE WORK WITH THE WORK OF ALL OTHER TRADES; AND PERFORMING THE WORK IN A SAFE AND SATISFACTORY MANNER.

VELLO Vanasse Hangen Brustlin, Inc. Engineers, Planners, and Scientists 54 Route 101A, Milton Rd. Bedford, NH 03103 603 644 0800

Job Number: 5DU499
Reviewed By: JAR
Date: 3-26-99

REV.	REMARKS	DATE	DWN	CHK	APP	Q.A.	NO.	DIA.	LGT	TYPE	WASHER
	OUT FOR APPROVAL										
	OUT FOR APPROVAL										
	ISSUED TO SHOP										
	FIELD & OFFICE										

PROJECT NO. IR-089-1(13) STATE PROJECT NO. 11N & 11S

MATERIAL: AASHTO-M270 GRADE 36 ELECTRODES: PER PROC. HOLES: 13/16" ϕ SHOP BOLTS: 3/4" ϕ A325

SURFACE PREP. & PAINT:

GALVANIZED AFTER FAB - PER ASTM-A-153

DESCRIPTION: CURB PLATES

JOB: I-89 - NB & SB OVER WHITE RIVER, VT. 14 & NECR HARTFORD, VT.

CUSTOMER: WINTERSET INC.

	DRAWN BY	DATE
	JPF	3-99
	CHKD BY	
	EJ.	
	APPROV BY	
	Q.A.	

CASCO BAY STEEL STRUCTURES, INC.
5 INDUSTRY ROAD SOUTH PORTLAND, ME. 04106
PHONE (207) 772-2533 FAX. (207) 772-0580

JOB NO.	DRG. NO.
048	4
107	REV. △