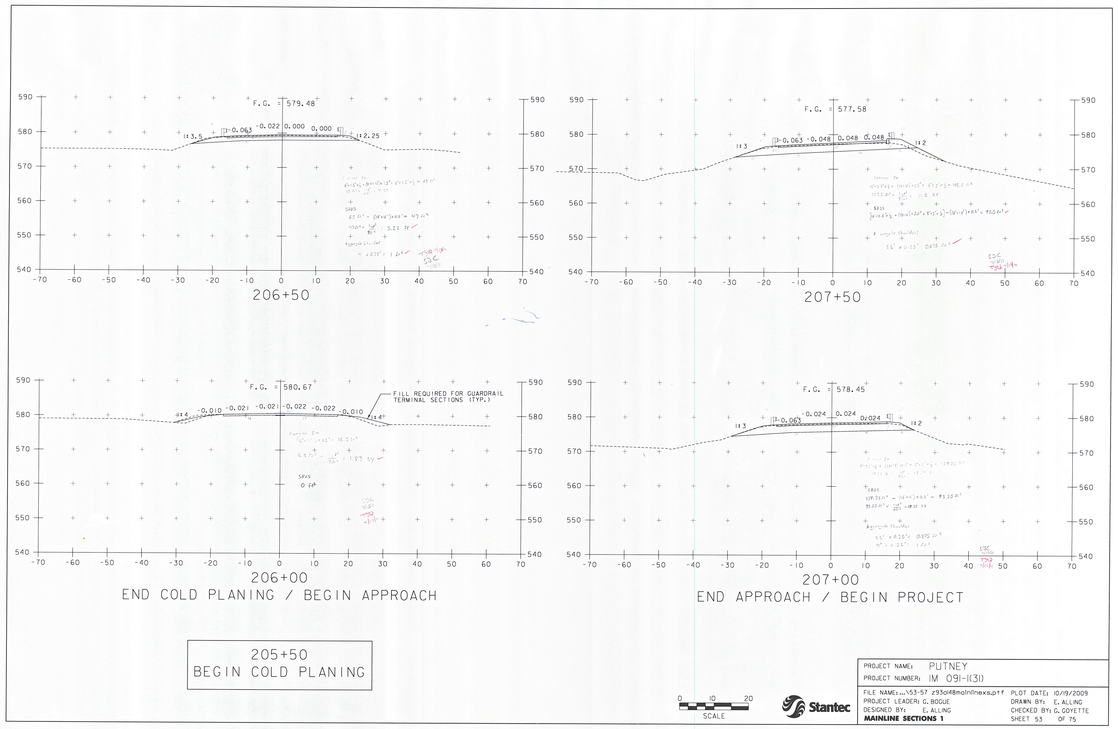

205+50
BEGIN COLD PLANING

0 10 20
SCALE

Stantec

PROJECT NAME: PUTNEY	
PROJECT NUMBER: M 091-(31)	
FILE NAME: ...\53-57 z33c48moinlinexs.dgn	PLOT DATE: 10/19/2009
PROJECT LEADER: G. BOGUE	DRAWN BY: E. ALLING
DESIGNED BY: E. ALLING	CHECKED BY: G. GOYETTE
MAINLINE SECTIONS 1	SHEET 53 OF 75