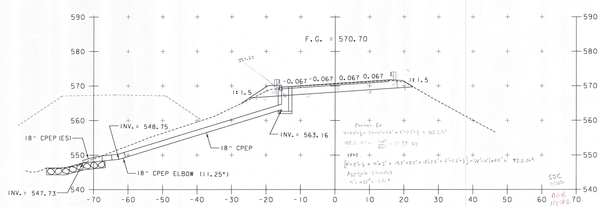

212+00

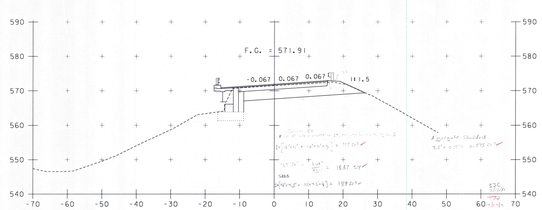

211+50

211+34.93
END BRIDGE

0 10 20
SCALE

Stantec

PROJECT NAME: PUTNEY
PROJECT NUMBER: IM 091-1(31)

FILE NAME: ...\53-57 z93a048mainlinexs.prf
PROJECT LEADER: G. BOGUE
DESIGNED BY: E. ALLING
MAINLINE SECTIONS 4

PLOT DATE: 10/19/2009
DRAWN BY: E. ALLING
CHECKED BY: G. GOYETTE
SHEET 56 OF 75