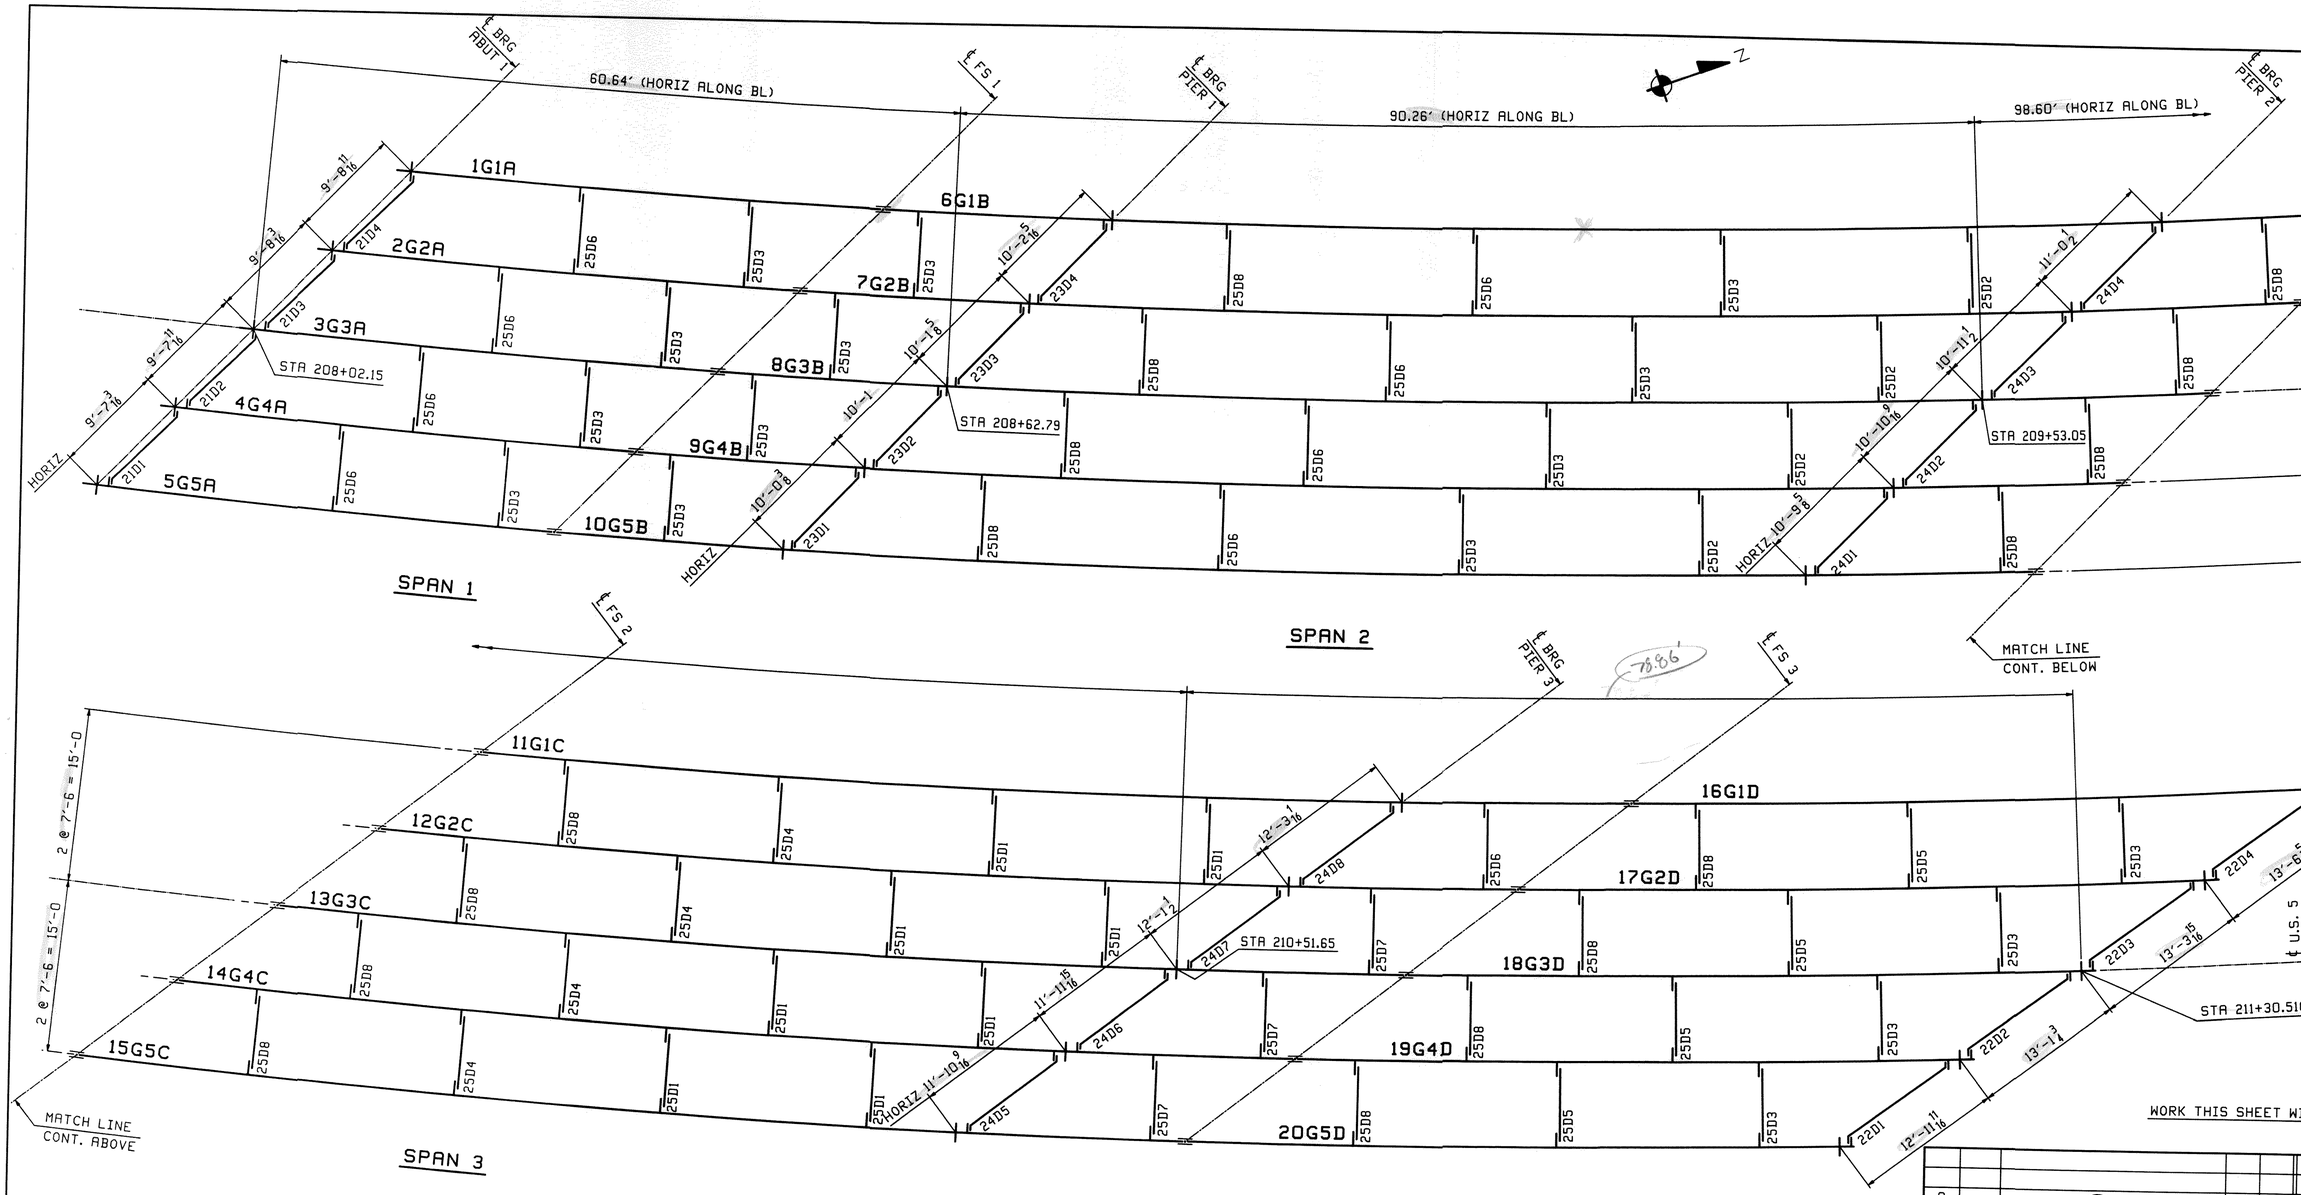

FRAMING PLAN

REV.	DATE	REMARKS	DWN	CHK
0				

MATERIAL:

SURFACE PREP. & PAINT:

HOLES: AS NOTED

DESCRIPTION: FRAMING PLAN

CASCO BAY STEEL STRUCTURES, INC.
75 SPRING HILL ROAD SACO, MAINE 04072
PHONE (207) 282-7360 FAX. (207) 282-1179

STRUCTURE: U.S. 5 over I-91
Bridge No. 19A
Putney
County of Windham

LOCATION: Putney

PROJ NO. IM 091-1(31)

CUSTOMER: VT ROT

SHOP DRAWINGS ARE REVIEWED WITH FABRICATION PERMITTED

NO EXCEPTION AFFIN

REVISE AS NOTED
RESUBMISSION NOT REQUIRED

REVISE AS NOTED
RESUBMISSION REQUIRED

REJECTED

DATE 2/9/10

SIGNATURE

REVIEW BY STANTEC IS FOR THE SOLE PURPOSE OF ASCERTAINING GENERAL COMPLIANCE WITH DESIGN. CONTRACTOR IS RESPONSIBLE FOR DIMENSIONS, FABRICATION AND CONSTRUCTION METHODS, COORDINATION OF SUB-TRADES, DETAIL DESIGN OF COMPONENTS, AND ERRORS OR OMISSIONS ON SHOP DRAWINGS