ABM INFO		SHIP	BILL OF MATERIAL					JOB NO. 438	DRAWING 4
PAGE	LINE	MARK	QTY	MARK	MATERIAL	LENGTH FT	LENGTH INCHES	REMARKS	WT
		4G4A	1		GIRDER				8280
5	S		1	wa	PL $\frac{1}{2}$x34	41	$1\frac{5}{16}$	M270-50WT2	
3	U		1	ta	PL 1x16	41	$\frac{5}{16}$	M270-50WT2	
2	G		1	ba	PL $1\frac{1}{2}$x16	41	$0\frac{5}{8}$	M270-50WT2	
6	K		1	x2a	PL $\frac{7}{8}$x$7\frac{3}{4}$	2	10	MIE	
6	K		1	x2b	PL $\frac{7}{8}$x$7\frac{3}{4}$	2	10	MIE	
6	L		1	x2c	PL $\frac{1}{2}$x$7\frac{1}{2}$	2	10		
6	L		4	x2d	PL $\frac{1}{2}$x$7\frac{1}{2}$	2	10		

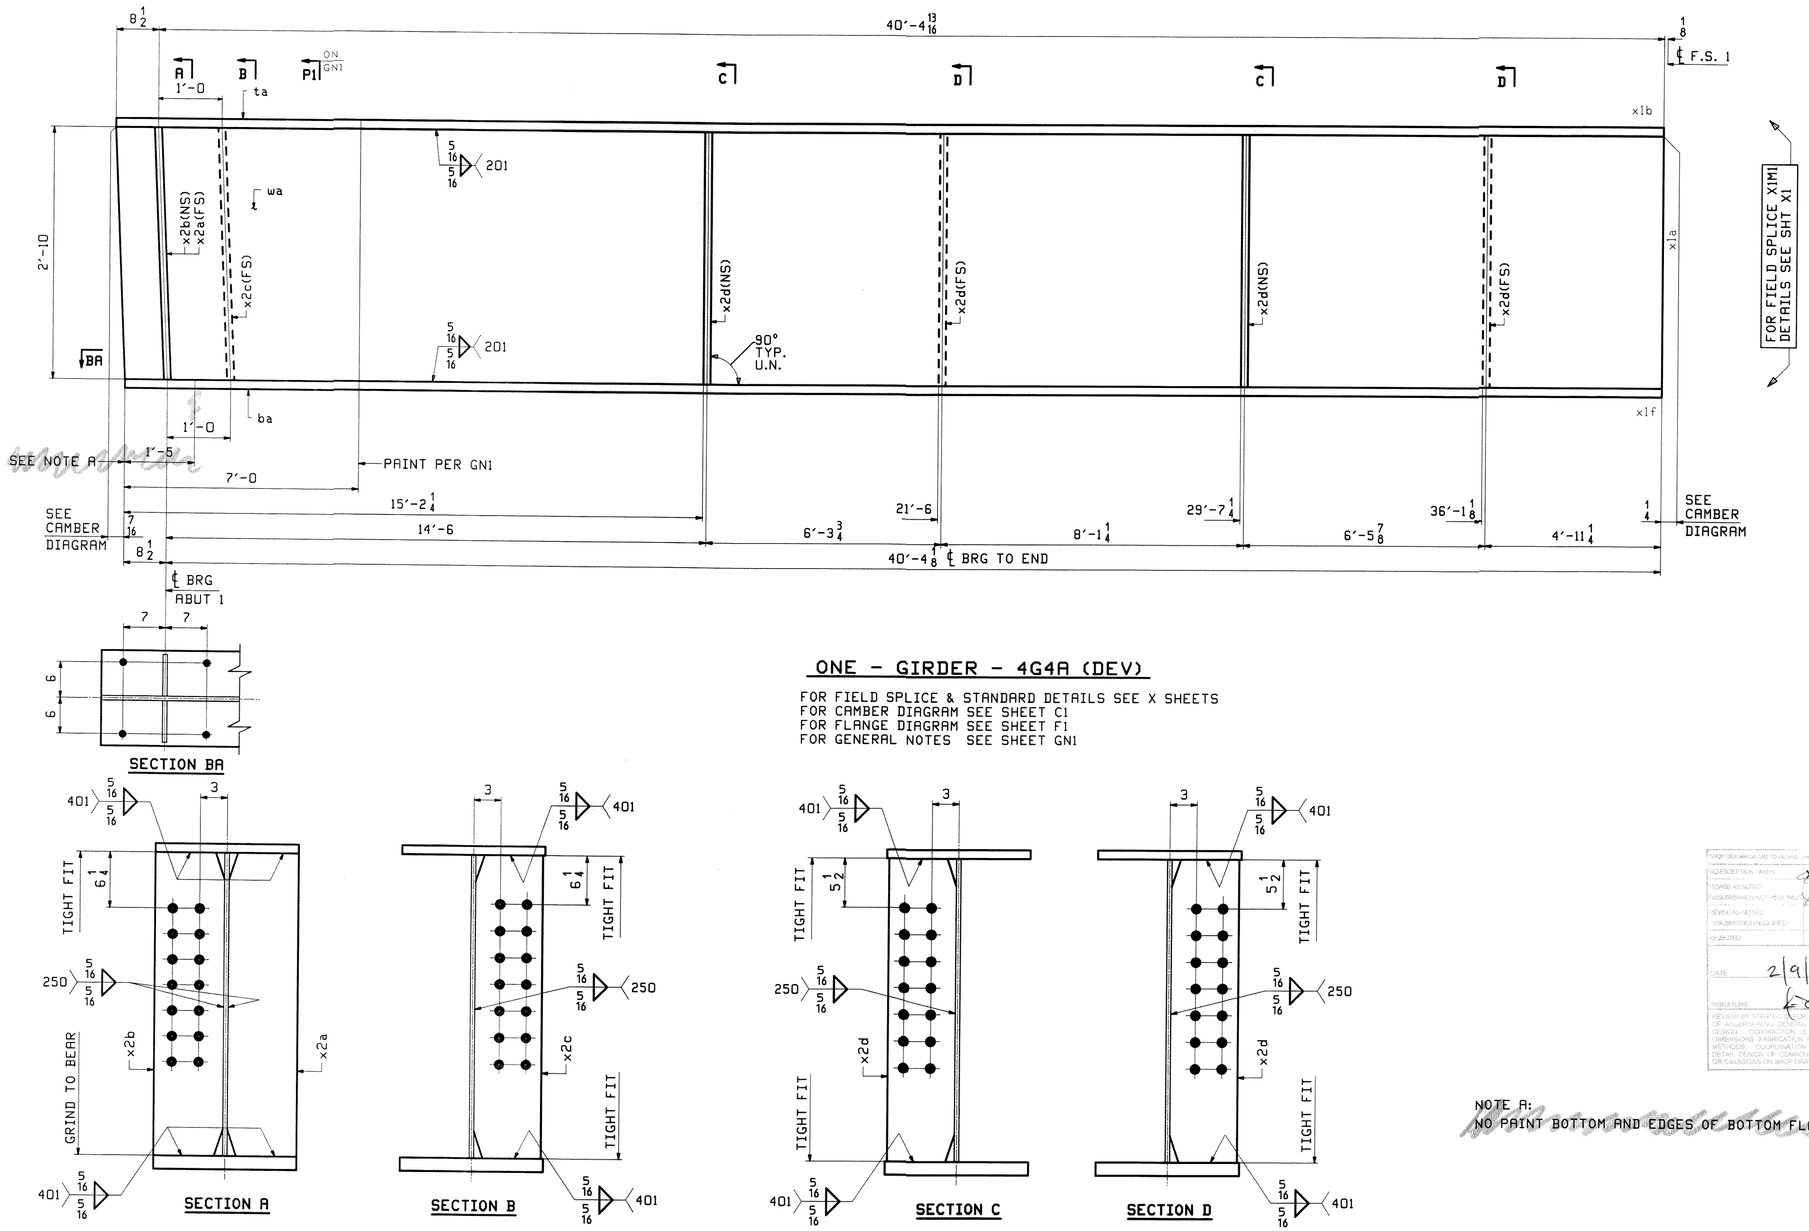

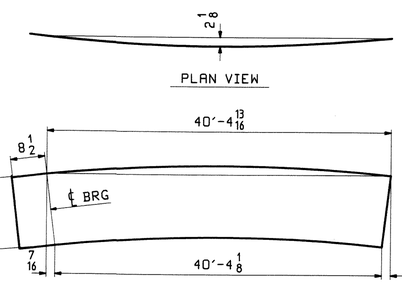

ONE - GIRDER - 4G4A (DEV)

FOR FIELD SPLICE & STANDARD DETAILS SEE X SHEETS
FOR CAMBER DIAGRAM SEE SHEET C1
FOR FLANGE DIAGRAM SEE SHEET F1
FOR GENERAL NOTES SEE SHEET GN1

NOTE A:
NO PAINT BOTTOM AND EDGES OF BOTTOM FLANGE.

SHOP DRAWINGS ARE REVIEWED ONLY FOR GENERAL ARRANGEMENT
NO EXCEPTION MADE
REVISE AS NOTED
RESUBMISSION NOT REQUIRED
REVISE AS NOTED
RESUBMISSION REQUIRED
REJECTED
DATE 2/9/10
SIGNATURE
REVIEW BY STANTEC IS FOR THE SOLE PURPOSE OF ASCERTAINING GENERAL CONFORMITY WITH DESIGN. CONTRACTOR IS RESPONSIBLE FOR DIMENSIONS, FABRICATION AND CONSTRUCTION METHODS, COORDINATION OF SUB-TRADES, DETAIL DESIGN OF COMPONENTS, AND ERRORS OR OMISSIONS ON SHOP DRAWINGS

REV.	DATE	REMARKS	DWN	CHK	APVL
0					JAN 2 9 2010

MATERIAL: M270-50W (UN)
SURFACE PREP. & PAINT: SEE GN1
HOLES: $\frac{15}{16}$"ø U.N.
SHOP BOLTS:
DESCRIPTION: GIRDER - 4G4A

CASCO BAY STEEL STRUCTURES, INC.
75 SPRING HILL ROAD SACO, MAINE 04072
PHONE (207) 282-7360 FAX. (207) 282-1179

STRUCTURE: U.S. 5 over I-91
Bridge No. 19A
Putney
County of Windham

DRAWN: WJF
CHKD: DO

LOCATION: Putney
PROJ NO. IM 091-1(31)
CUSTOMER: VT AOT
JOB NO. 438