ABM INFO		SHIP	BILL OF MATERIAL					JOB NO. 438	D
PAGE	LINE	MARK	QTY	MARK	MATERIAL	LENGTH FT	LENGTH INCHES	REMARKS	WT
		18G3D	1		GIRDER				121
4	N		1	wa	PL $\frac{1}{2}$x34	60	$4\frac{7}{16}$	M270-50WT2	
2	S		1	ta	PL 1x16	60	4	M270-50WT2	
1	E		1	ba	PL $1\frac{1}{2}$x16	60	$4\frac{3}{16}$	M270-50WT2	
6	K		2	x2a	PL $\frac{7}{8}$x$7\frac{3}{4}$	2	10	MIE	
6	L		2	x2c	PL $\frac{1}{2}$x$7\frac{1}{2}$	2	10		
6	L		6	x2d	PL $\frac{1}{2}$x$7\frac{1}{2}$	2	10		

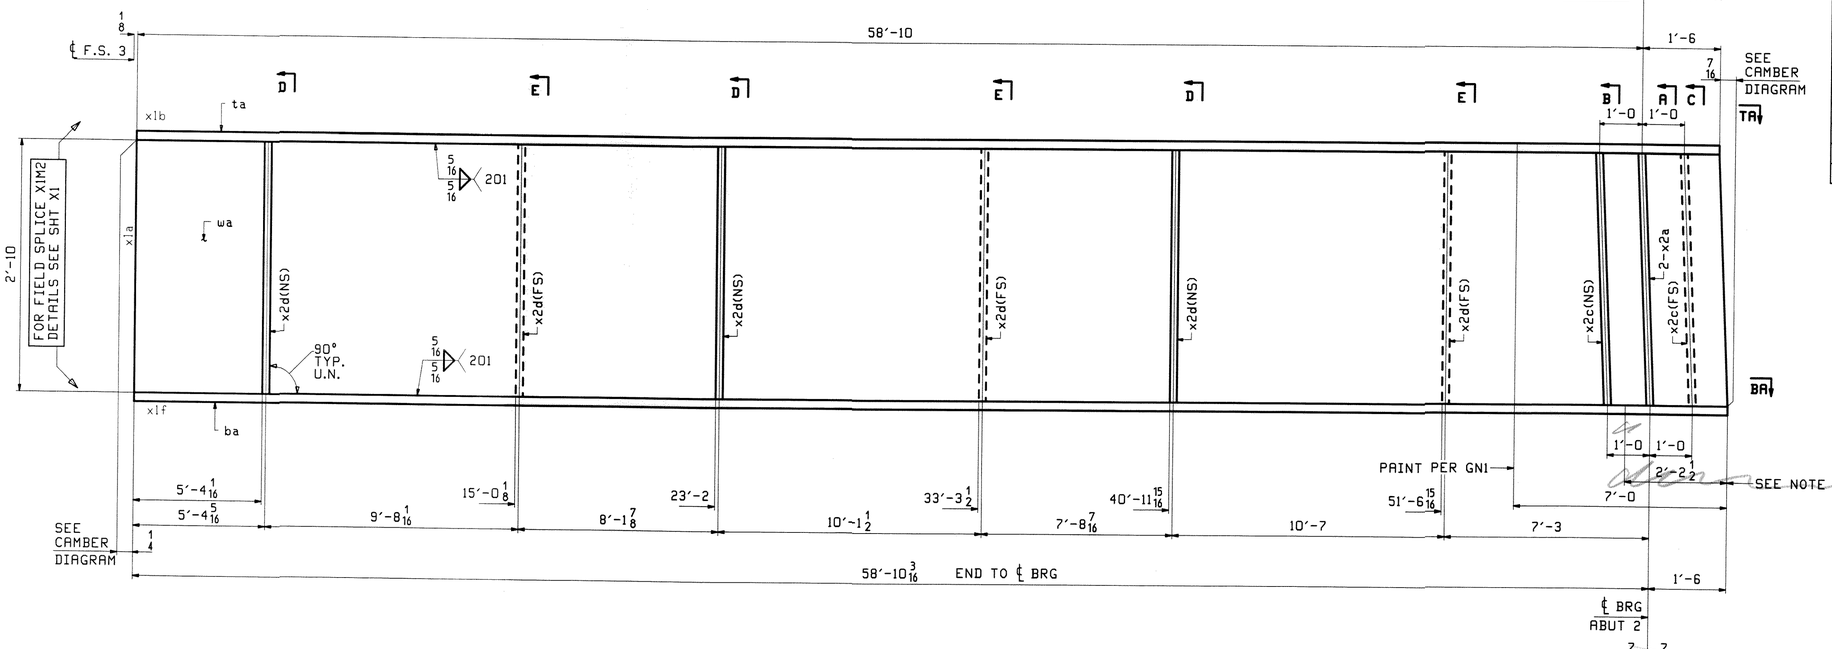

NOTE A:
NO PAINT BOTTOM AND EDGES OF BOTTOM FLA

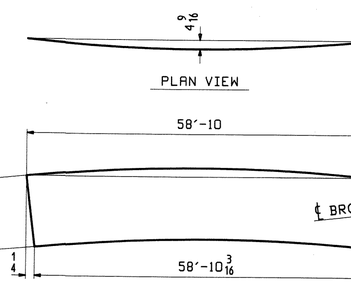

ONE - GIRDER - 18G3D (DEV)

FOR FIELD SPLICE & STANDARD DETAILS SEE X SHEETS
FOR CAMBER DIAGRAM SEE SHEET C2
FOR FLANGE DIAGRAM SEE SHEET F1
FOR GENERAL NOTES SEE SHEET GN1

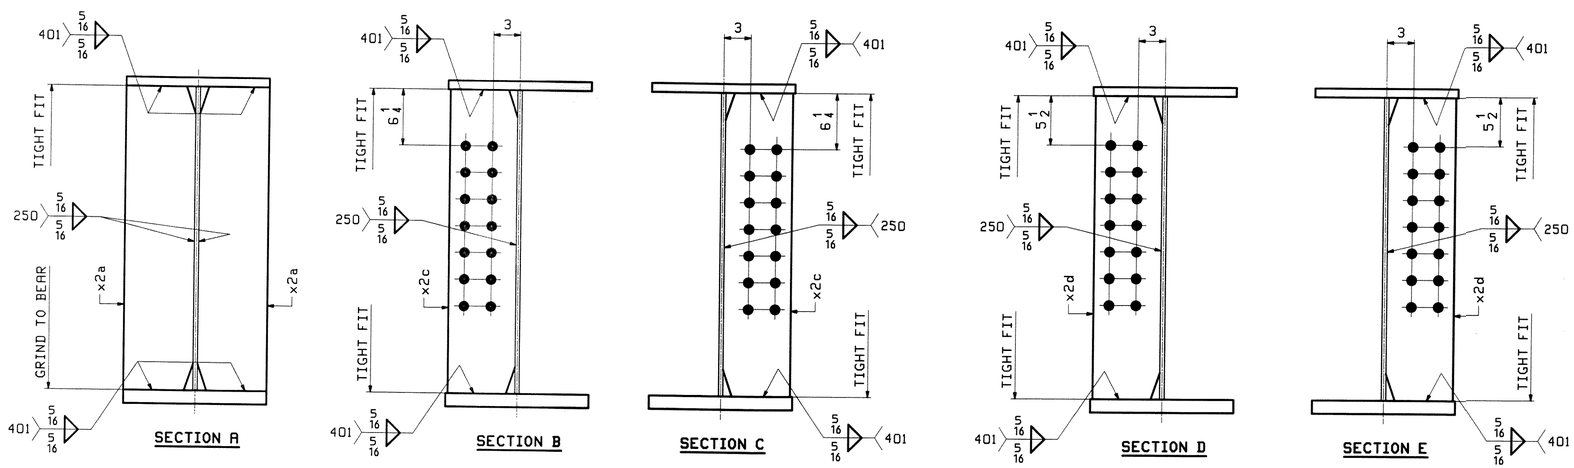

REV.	DATE	REMARKS	DWN	CHK	APV
0					

MATERIAL: M270-50W (UN)
SURFACE PREP. & PAINT: SEE GN1
HOLES: $\frac{15}{16}$"Ø U.N.
DESCRIPTION: GIRDER - 18G3D

CASCO BAY STEEL STRUCTURES, INC.
75 SPRING HILL ROAD SACO, MAINE 04072
PHONE (207) 282-7360 FAX. (207) 282-1179

STRUCTURE: U.S. 5 over I-91
Bridge No. 19A
Putney
County of Windham

DRAWN: WJF
CHKD: DO

LOCATION: Putney
PROJ NO. IM 091-1(31)
CUSTOMER: VT AOT

JOB NO 438

2/9/10