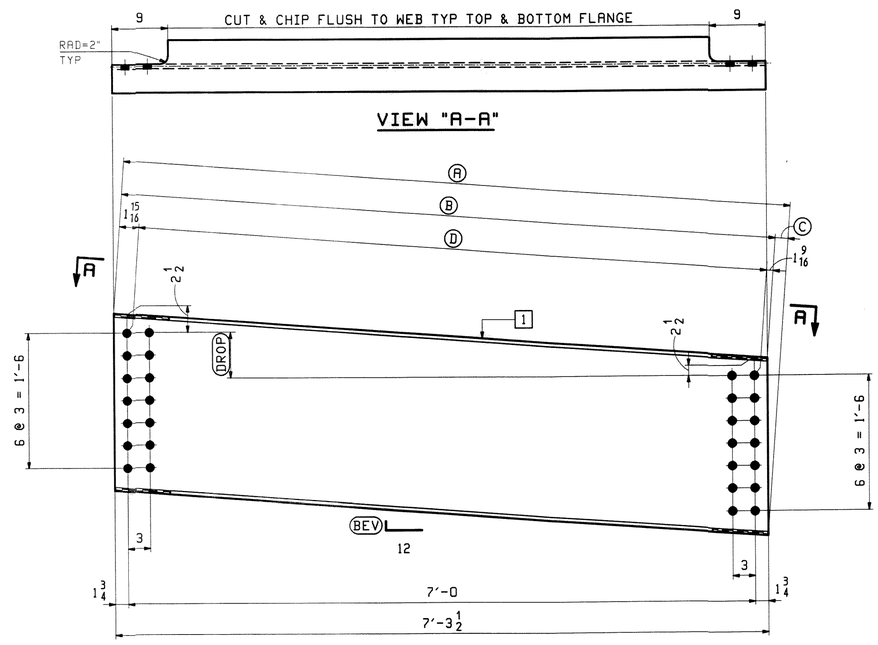

INTERMEDIATE DIAPHRAGMS

LOOKING DOWNSTATION

MARK	QTY.	DROP	BEVEL	A	B	C	D	E	F
25D1	8	5 1/2	13/16	7'-5 1/4	7'-3 11/16	1 9/16	7'-0 3/16	1 15/16	1 5/8
25D2	4	5 5/8	13/16	7'-5 1/4	7'-3 11/16	1 9/16	7'-0 3/16	1 15/16	1 9/16
25D3	16	5 3/4	13/16	7'-5 5/16	7'-3 11/16	1 5/8	7'-0 3/16	1 15/16	1 9/16
25D4	4	6	7/8	7'-5 3/8	7'-3 11/16	1 11/16	7'-0 3/16	1 15/16	1 9/16
25D5	4	6 1/8	7/8	7'-5 7/16	7'-3 3/4	1 11/16	7'-0 1/4	1 15/16	1 9/16
25D6	9	6 1/4	7/8	7'-5 1/2	7'-3 3/4	1 3/4	7'-0 1/4	1 15/16	1 9/16
25D7	3	6 3/8	15/16	7'-5 9/16	7'-3 3/4	1 13/16	7'-0 1/4	1 15/16	1 9/16
25D8	16	6 1/2	15/16	7'-5 9/16	7'-3 3/4	1 13/16	7'-0 1/4	1 15/16	1 9/16

BILL OF MATERIAL

ABM INFO PAGE	ABM INFO LINE	SHIP MARK	QTY	MARK	MATERIAL	LENGTH FT	LENGTH INCHES	REMARKS	WT
		25D1	8		INTR DIAPHRAGM				409
7	B		8	a25	W 24x55	7	5 1/4	M270-50WT2	
		25D2	4		INTR DIAPHRAGM				409
7	B		4	b25	W 24x55	7	5 1/4	M270-50WT2	
		25D3	16		INTR DIAPHRAGM				409
7	B		16	c25	W 24x55	7	5 5/16	M270-50WT2	
		25D4	4		INTR DIAPHRAGM				410
7	B		4	d25	W 24x55	7	5 3/8	M270-50WT2	
		25D5	4		INTR DIAPHRAGM				410
7	B		4	f25	W 24x55	7	5 7/16	M270-50WT2	
		25D6	9		INTR DIAPHRAGM				410
7	B		9	g25	W 24x55	7	5 1/2	M270-50WT2	
		25D7	3		INTR DIAPHRAGM				410
7	B		3	h25	W 24x55	7	5 9/16	M270-50WT2	
		25D8	16		INTR DIAPHRAGM				410
7	B		16	k25	W 24x55	7	5 9/16	M270-50WT2	

JOB NO. 438

DRAWIN 25

REV.	DATE	REMARKS	DWN	CHK	APVL
0					JAN 2 0

MATERIAL: M270-50W (UN)
SURFACE PREP. & PAINT: SEE GN1
HOLES: 15/16 Ø
SHOP

DESCRIPTION: INT DIAPHRAGMS

CASCO BAY STEEL STRUCTURES, INC.
75 SPRING HILL ROAD SACO, MAINE 04072
PHONE (207) 282-7360 FAX. (207) 282-1179

STRUCTURE: U.S. 5 over I-91
Bridge No. 19A
Putney
County of Windham

DRAWN: TS
CHKD: DO

LOCATION: Putney
JOB NO
PROJ NO. IM 091-1(31)
438
CUSTOMER: VT AOT

DO NOT SCALE DRAWINGS ARE REVIEWED UNLESS NOTED OTHERWISE
DESCRIPTION: AS-NOTED
CHANGE AS NOTED
RESUBMIT WITH CHANGES AS NOTED
CHANGE AS NOTED
RESUBMIT NOT REQUIRED
REJECTED
DATE 2/9/10
SIGNATURE
REVIEW BY STANTEC IS ONLY FOR THE SCALE, PURPOSE & ABSOLUTE AND RELATIVE DIMENSIONS WITH ACCESS, CONSTRUCTION IS RESPONSIBLE FOR DIMENSIONS, FABRICATION, ERECTION, ALL CONSTRUCTION METHODS, COORDINATION OF SUB-TRADES, DETAIL DESIGN OF COMPONENTS, AND ERRORS IN DIMENSIONS ON SHOP DRAWINGS
Stantec

Fri, Jan 22, 2010 11:09:37 AM /users/jobs/7254/25/ Rev.0