JOB NO.	DRG. NO.
438	J2

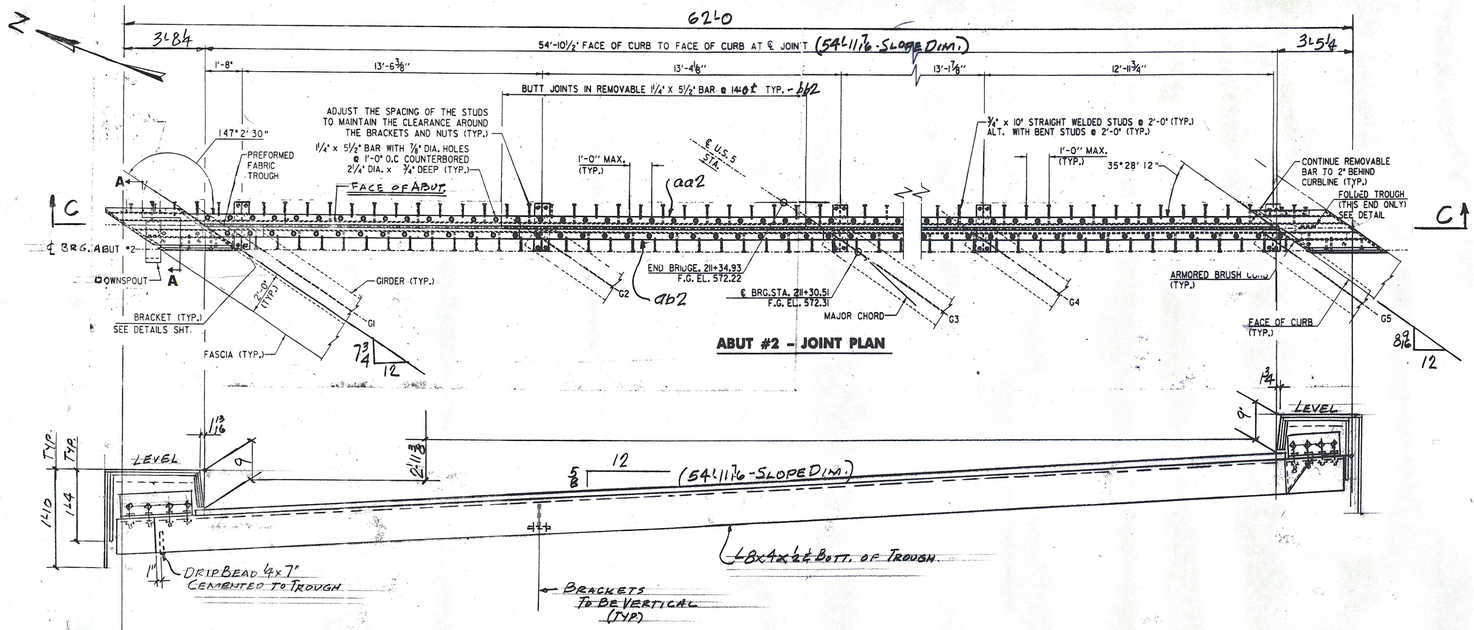

C-C

EJ2 - ONE REQ'D (@ ABUT. #2)

FOR CURB DETAILS & SHOP BILL - SEE DWG. J2A

SHOP DRAWINGS ARE REVIEWED UNLESS NOTED OTHERWISE

NO EXCEPTION TAKEN

REVISE AS NOTED

RESUBMISSION NOT REQUIRED

REVISE AS NOTED

RESUBMISSION REQUIRED

REJECTED

Stantec

DATE 4/22/10

SIGNATURE

REVIEW BY STANTEC IS FOR THE SOLE PURPOSE OF ASCERTAINING GENERAL CONFORMITY WITH DESIGN. CONTRACTOR IS RESPONSIBLE FOR DIMENSIONS, FABRICATION AND CONSTRUCTION METHODS, COORDINATION OF SUB-TRADES, DETAIL DESIGN OF COMPONENTS, AND ERRORS OR OMISSIONS ON SHOP DRAWINGS.

REV.	REMARKS	DATE	DWN	CHK	APP	Q.A.	NO.	DIA.	LGT	TYPE	WASHER
	OUT FOR APPROVAL	4/19/10									
	OUT FOR APPROVAL										
	ISSUED TO SHOP										
	FIELD & OFFICE										

PROJECT NO. IM 091-1(31) STATE PROJECT NO. BRIDGE N2194

MATERIAL: AASHTO M270-GR 36 | ELECTRODES: SEE REQ. | HOLES: AS NOTED | SHOP BOLTS: ¾" ø A325 GALV

SURFACE PREP. & PAINT:

GALVANIZE PER SUBSECT. 506.15

DESCRIPTION: EXP. JOINT - ABUT #2

JOB:

U.S. ROUTE 5 OVER I 91

PUTNEY, VERMONT

	DRAWN BY	DATE
	JPF	3-10
	CHKD BY	
	CR	
	APPROV BY	
	Q.A.	

CUSTOMER: J.A. McDONALD

CASCO BAY STEEL STRUCTURES, INC.

75 SPRING HILL ROAD SACO, MAINE 04072

PHONE (207) 282-7360 FAX. (207) 282-1179

JOB NO.	DRG. NO.
438	J2
	REV. △