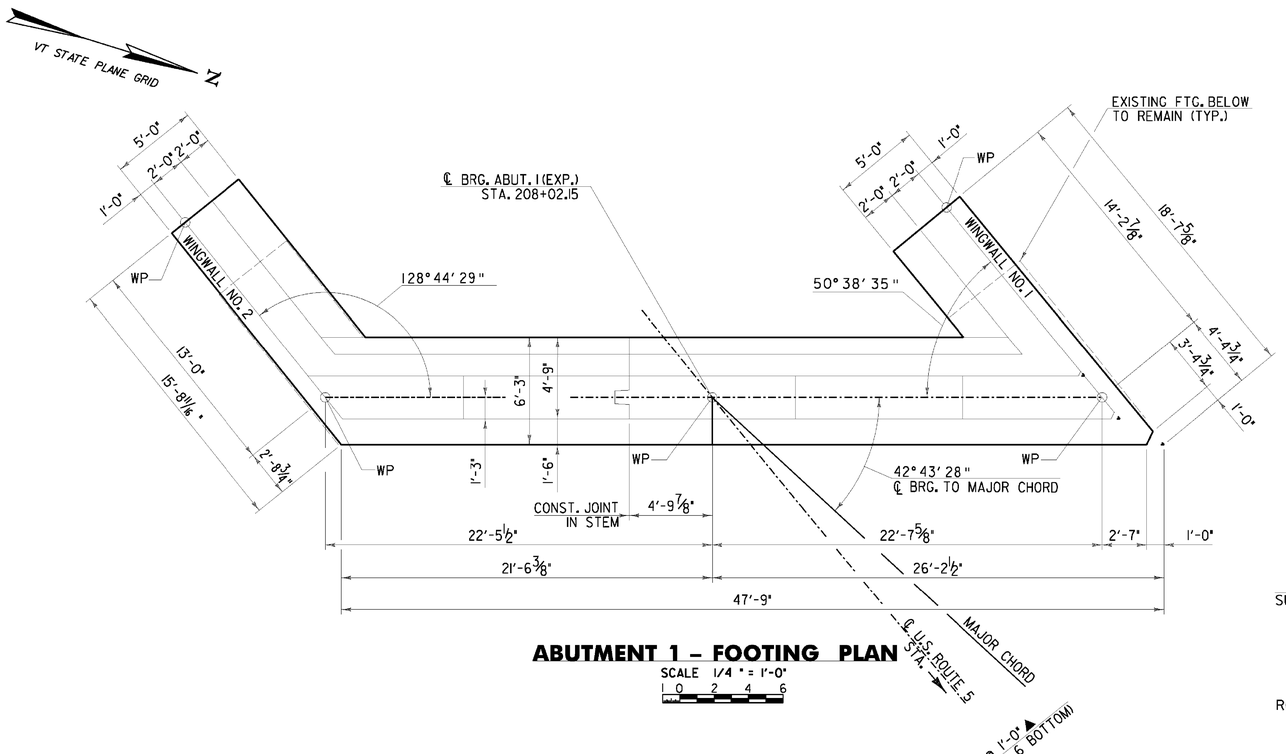

ABUTMENT 1 – FOOTING PLAN

SCALE 1/4 " = 1'-0"

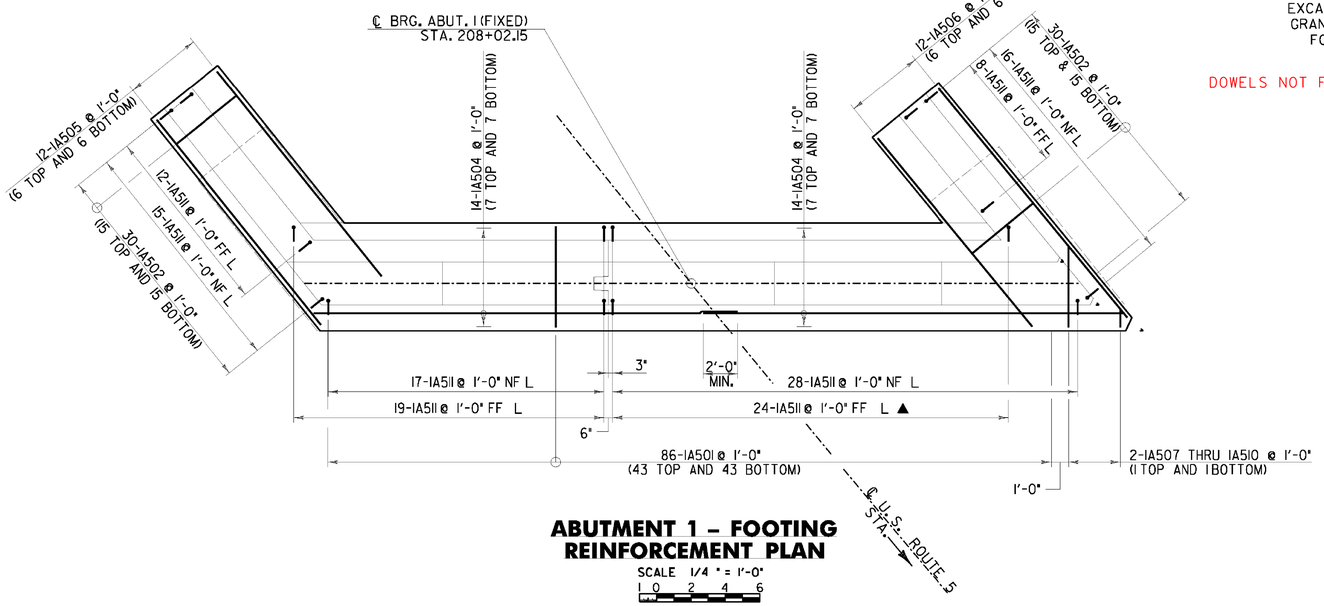

ABUTMENT 1 – FOOTING REINFORCEMENT PLAN

SCALE 1/4 " = 1'-0"

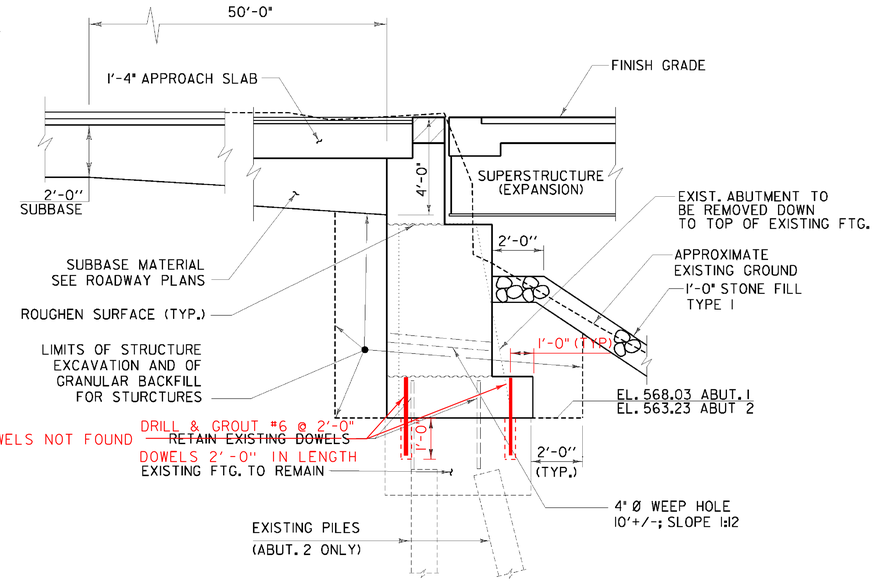

TYPICAL ABUTMENT SECTION

NOT TO SCALE

NOTE:

NF = NEAR FACE
FF = FAR FACE
EF = EACH FACE
▲ = CUT TO FIT IN FIELD
3" CLR. UNLESS OTHERWISE SPECIFIED ON THE PLANS.

Stantec

STATE OF VERMONT
AGENCY OF TRANSPORTATION

Town Of PUTNEY	Bridge No. 19A
Highway No.	Log Sta.
	Surv. Sta.

U.S. ROUTE 5 OVER I-91

ABUTMENT 1 FOOTING

Designed By T. KNIGHT	Drawn By R. WALKER
Checked By T. KNIGHT Date 06/09	Bridge Design Supervisor C. BOGUE Date 06/09
PROJECT PUTNEY	PROJECT NO. IM 091-1(31)
CAD Drawing Name: ...\41z93a148abtftgl.dgn	Plot Date: 7/8/2009
Bridge Sheet No.	Sheet 41 of 75