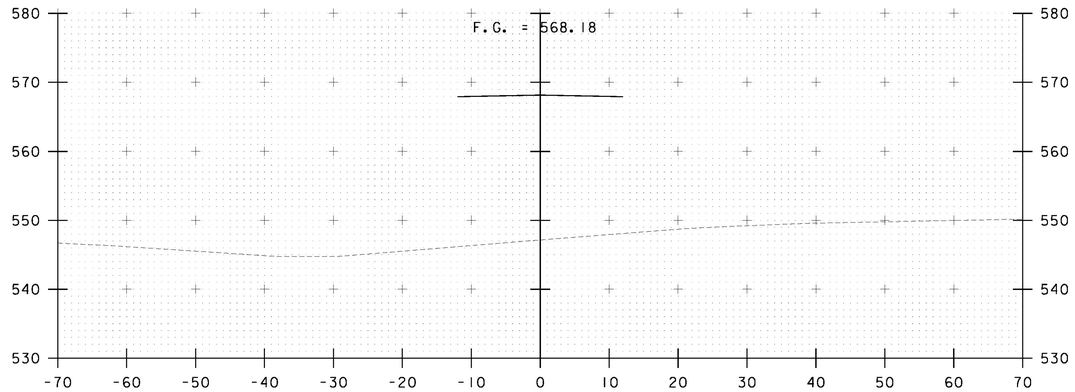

409+50

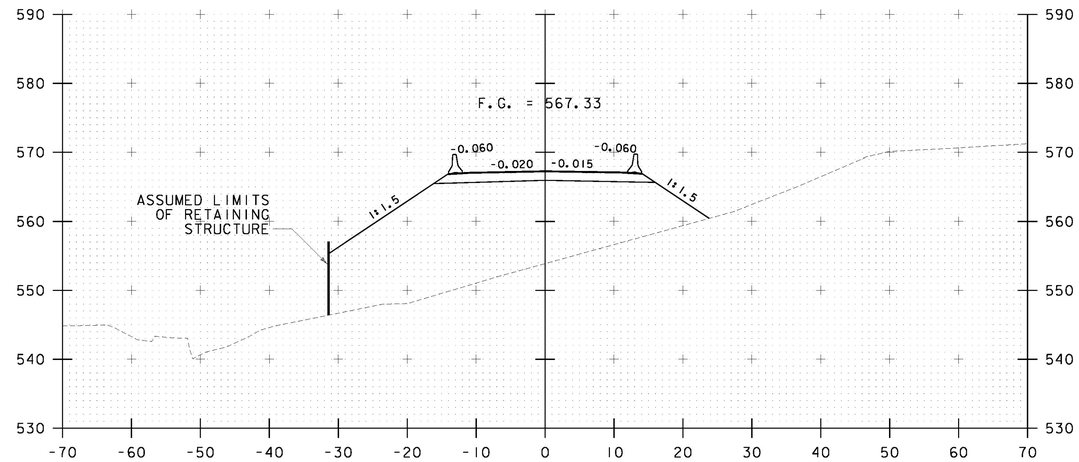

410+50

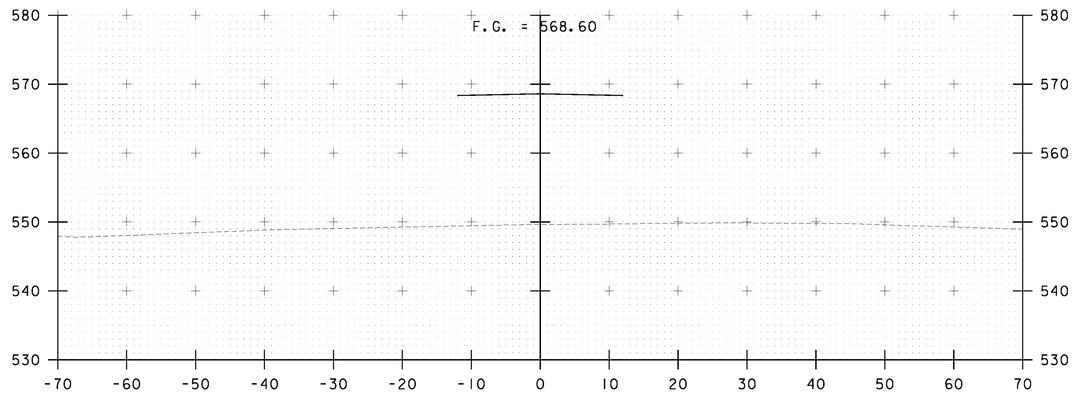

409+00

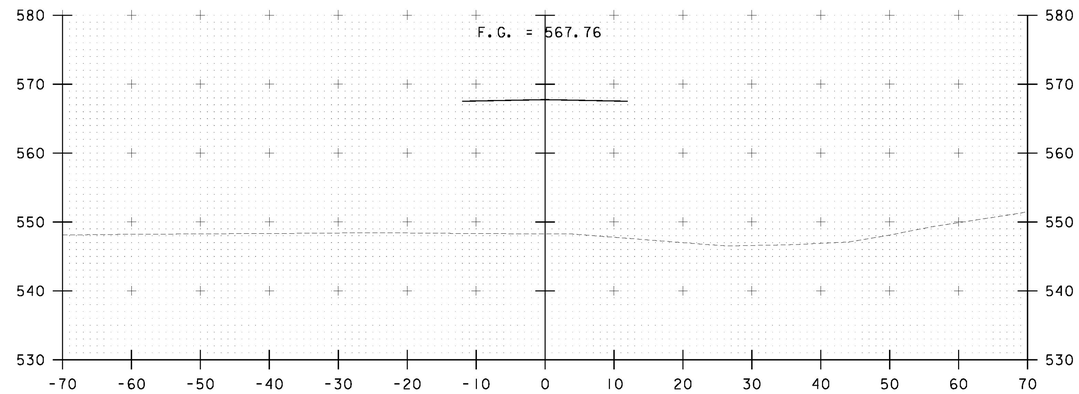

410+00

STA. 409+00 TO STA. 410+50

0 10 20
SCALE

Stantec

PROJECT NAME: PUTNEY
PROJECT NUMBER: IM 091-1(31)

FILE NAME: ...\58-62 z93a148tempdetourxs.pltcfg PLOT DATE: 7/8/2009
PROJECT LEADER: G. BOGUE DRAWN BY: E. ALLING
DESIGNED BY: E. ALLING CHECKED BY: G. GOYETTE
TEMPORARY DETOUR SECTIONS SHEET 61 OF 75