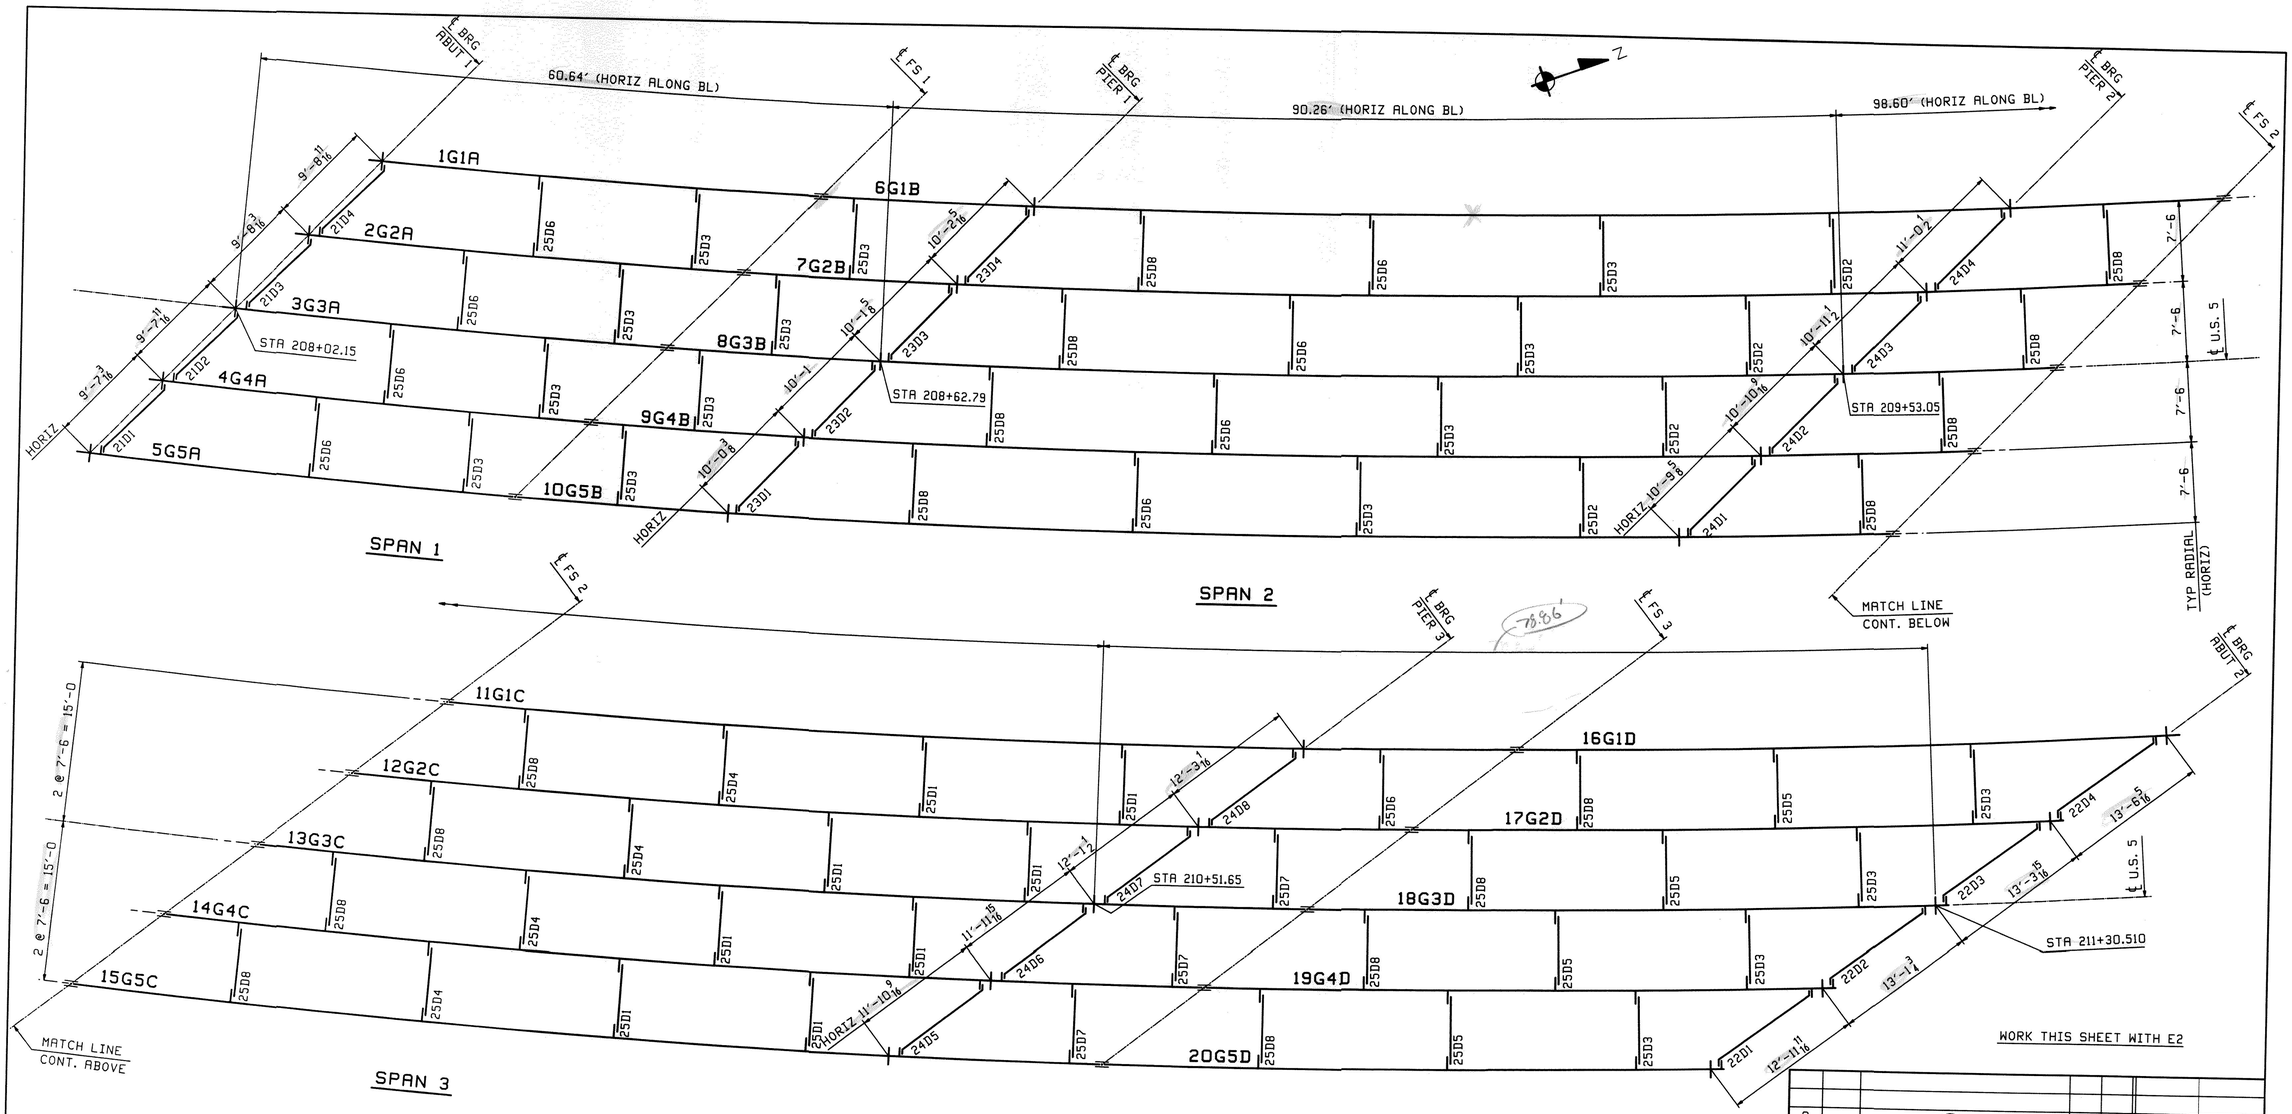

FRAMING PLAN

SHOP DRAWINGS ARE REVIEWED FOR GENERAL COMPLIANCE WITH THE CONTRACT DOCUMENTS AND THE DESIGN CONCEPT EXPRESSED THEREIN. NO EXCEPTION TAKEN / MAKE AS NOTED / FURNISH NOTED / REVISE AND RESUBMIT / RESUBMISSION REQUIRED / REJECTED

DATE: 2/9/10

SIGNATURE

REVIEW BY STANTEC IS FOR THE SOLE PURPOSE OF ASCERTAINING GENERAL CONFORMITY WITH DESIGN. CONTRACTOR IS RESPONSIBLE FOR DIMENSIONS, FABRICATION AND CONSTRUCTION METHODS, COORDINATION OF SUB-TRADES, DETAIL DESIGN OF COMPONENTS, AND ERRORS OR OMISSIONS ON SHOP DRAWINGS

REV.	DATE	REMARKS	DWN	CHK	APVL	SHOP
0						

MAR 2 2 2010

MATERIAL:	SURFACE PREP. & PAINT:	HOLES:	SHOP BOLTS:
		AS NOTED	AS NOTED

DESCRIPTION: FRAMING PLAN

CASCO BAY STEEL STRUCTURES, INC.
75 SPRING HILL ROAD SACO, MAINE 04072
PHONE (207) 282-7360 FAX. (207) 282-1179

TENSOR 2945

STRUCTURE: U.S. 5 over I-91 Bridge No. 19A Putney County of Windham	DRAWN: TS	DATE: 01/11	
	CHKD: DO	DATE: 01/21	
LOCATION: Putney	JOB NO. 438	DWG NO. E1	
PROJ NO. IM 091-1(31)			
CUSTOMER: VT AOT		REV. △	

DO Fri, Jan 22, 2010 11:08:10 AM K:\area1\2945\2945-E1.dwg