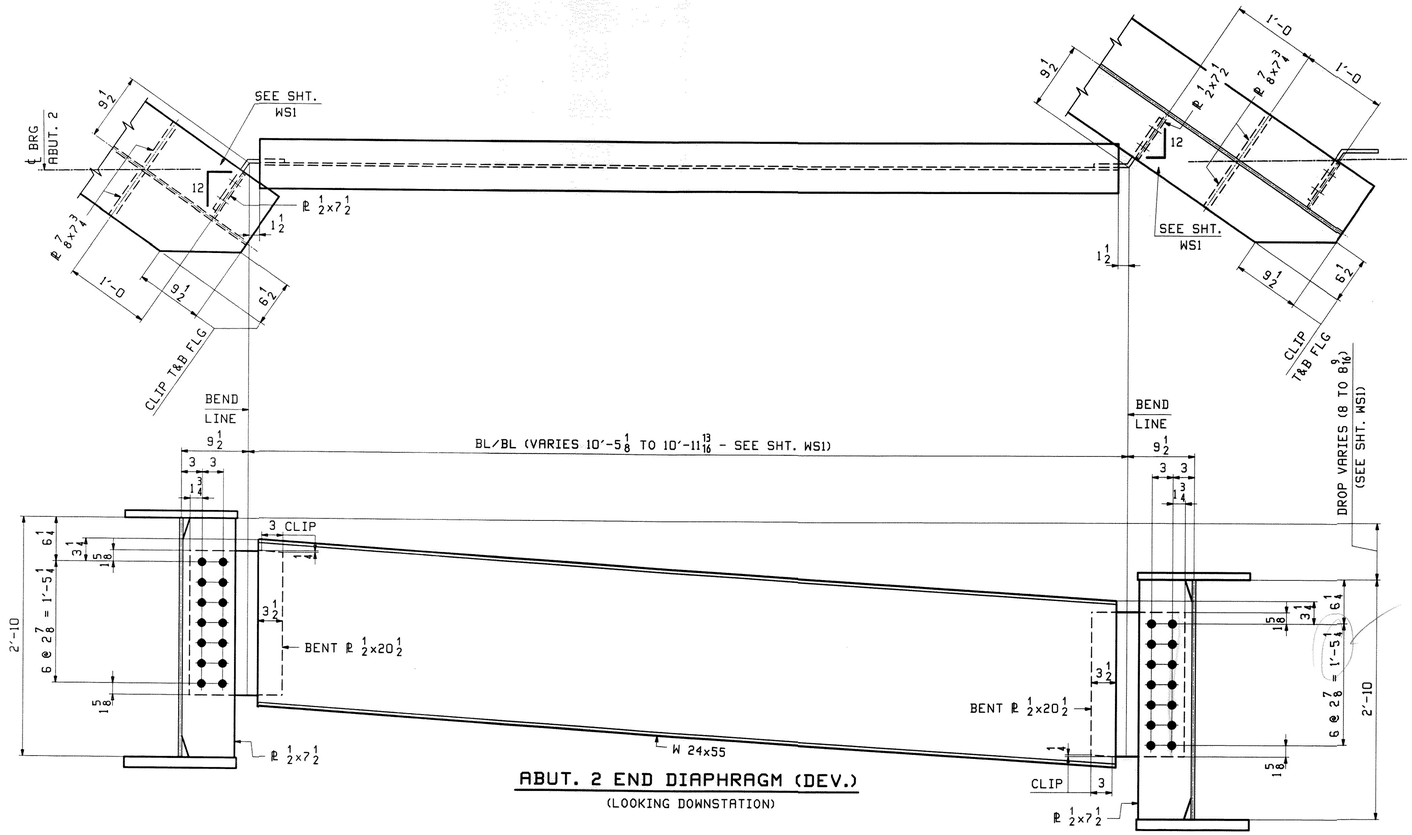

ABUT. 2 END DIAPHRAGM (DEV.)

(LOOKING DOWNSTATION)

**** NOTE ****
THE PURPOSE OF THIS DRAWING IS TO COORDINATE GEOMETRIC CONTROL INFORMATION AND CONNECTION SPACING. THIS DWG IS SUBMITTED FOR INFORMATION ONLY & IS NOT INTENDED FOR SHOP FABRICATION. DETAIL DWGS WILL SHOW ALL WELDING AND DIMENSIONS REQ'D FOR FABRICATION.

NOTES:
- MAT'L SHALL BE M270 GR50W
- HOLES SHALL BE 15/16"Ø
- BOLTS SHALL BE 7/8"Ø
- ABUT DIAPHRAGM SHALL BE PAINTED AND HAVE A325 TYPE 1 (GALV) BOLTS

"SHOP DRAWINGS ARE REVIEWED UNLESS NOTED OTHERWISE"
- NO EXCEPTION TAKEN
- REVISE AS NOTED
- RESUBMISSION NOT REQUIRED
- REVISE AS NOTED
- RESUBMISSION REQUIRED
- REJECTED

X

Stantec

DATE 2/9/10

SIGNATURE

"ENGINEER BY STANTEC REVIEWS FOR THE SOLE PURPOSE OF ASSERTAINING GENERAL CONFORMITY WITH DESIGN. CONTRACTOR IS RESPONSIBLE FOR DIMENSIONS, FABRICATION AND CONSTRUCTION METHODS, COORDINATION OF SUB-TRADES, DETAIL DESIGN OF CONNECTIONS, AND ERRORS OR OMISSIONS ON SHOP DRAWINGS"

REV.	DATE	REMARKS	DWN	CHK	APVL	SHOP
0					JAN 29 2010	

MATERIAL:	SURFACE PREP. & PAINT:	HOLES:	SHOP BOLTS:
		AS NOTED	AS NOTED

DESCRIPTION: TYPICAL LAYOUTS

CASCO BAY STEEL STRUCTURES, INC.
75 SPRING HILL ROAD SACO, MAINE 04072
PHONE (207) 282-7360 FAX. (207) 282-1179
TENSOR 2945

STRUCTURE:	U.S. 5 over I-91 Bridge No. 19A Putney County of Windham	DRAWN: SOB	DATE: 01/05
		CHKD: PCP	DATE: 01/07
LOCATION:	Putney	JOB NO.	DWG NO.
PROJ NO.	IM 091-1(31)	438	TD2
CUSTOMER:	VT AOT		REV. △

PCP Thu, Jan 2, 2010 02:00:57 PM /users/jobs/2945/TD2 Rev.0